


T1S, R3W, WM

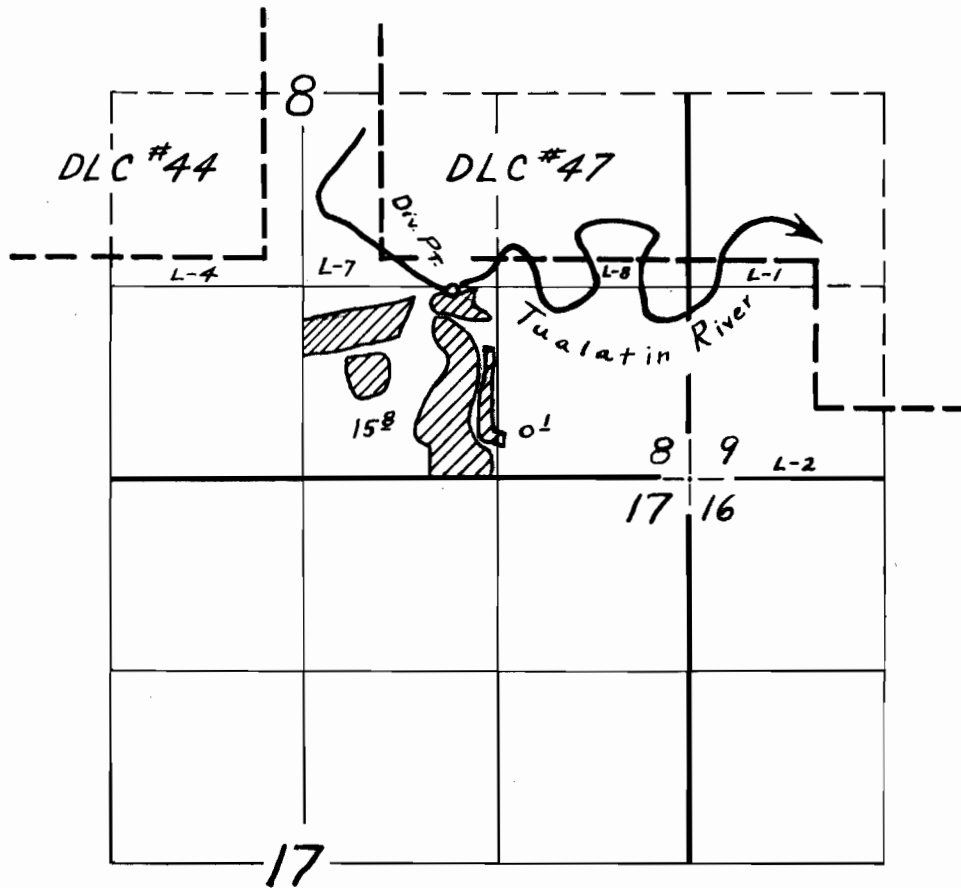

**FINAL PROOF SURVEY**

UNDER

Application No. 28690 Permit No. 22591

IN NAME OF

CECIL E. HINES

Surveyed 5-2 1956, by R.D.BEST