


T. 3 S. R. 8 E 8 1/2 E. W. M.

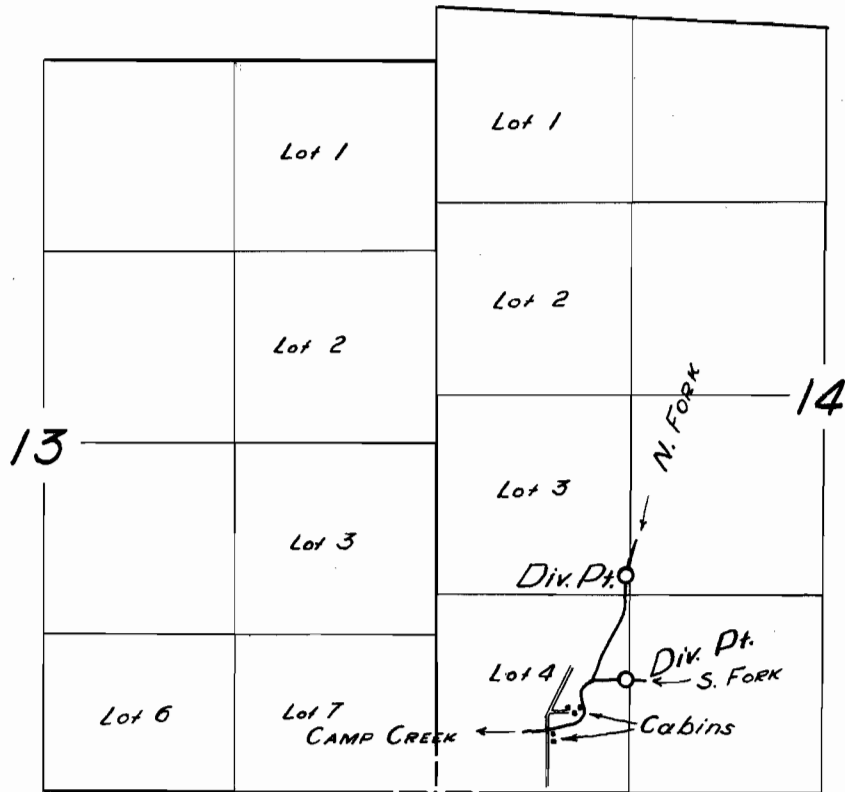

FINAL PROOF SURVEY
UNDER

Application No. 17641 Permit No. 13338
IN NAME OF

JOHN MULKEY

Surveyed 13 June 1956, by *[Signature]*