


T 7 N. R. 10 W. W. M.

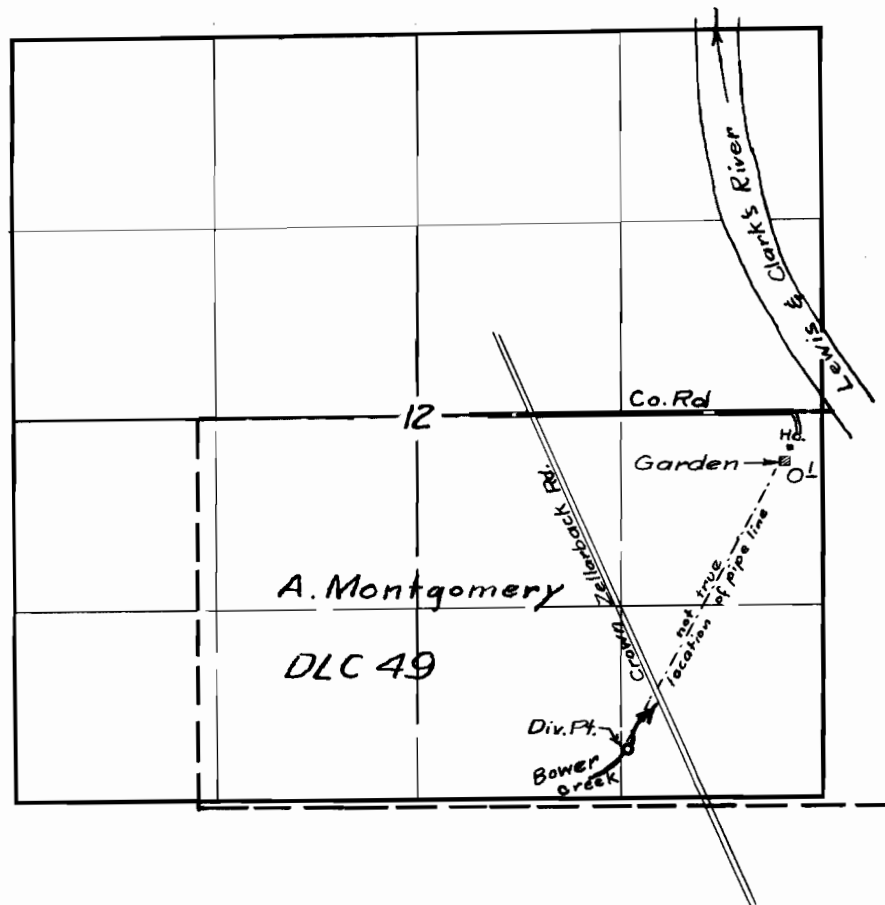

FINAL PROOF SURVEY
UNDER

Application No. 17655 Permit No. 13350
IN NAME OF

J. D. Heckard

Surveyed 22 Aug. 1956, by M. Bish