


T. 4 N. R. 10 W. W.M.

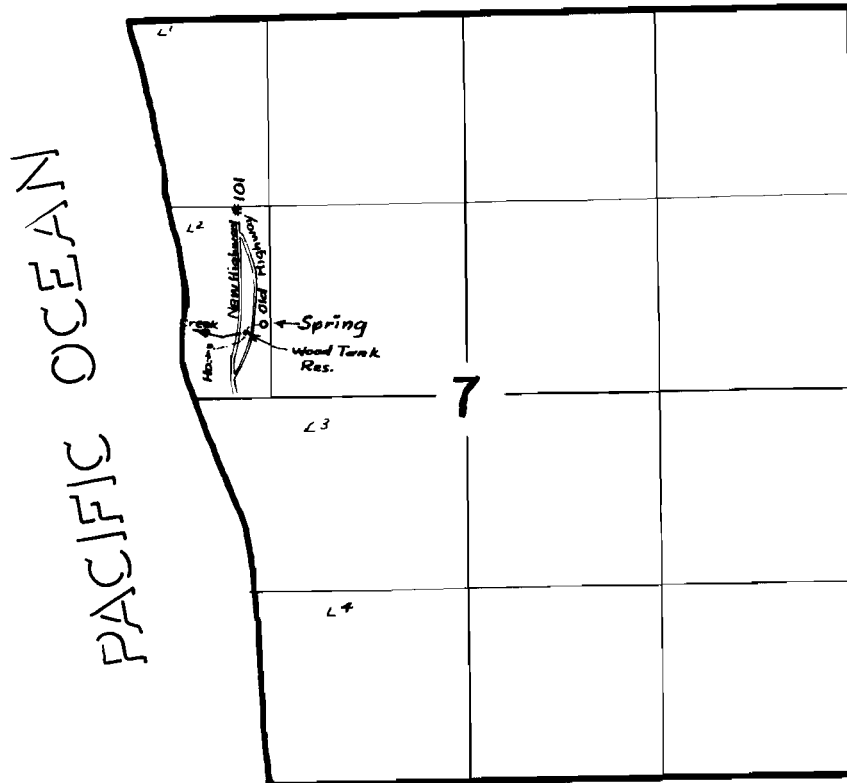

FINAL PROOF SURVEY
UNDER

Application No. 17848 Permit No. 13533
IN NAME OF

Sam B. Foster

Surveyed 14 June 1956, by M. B. B.