


T. 5S. R. 1W. W.M.

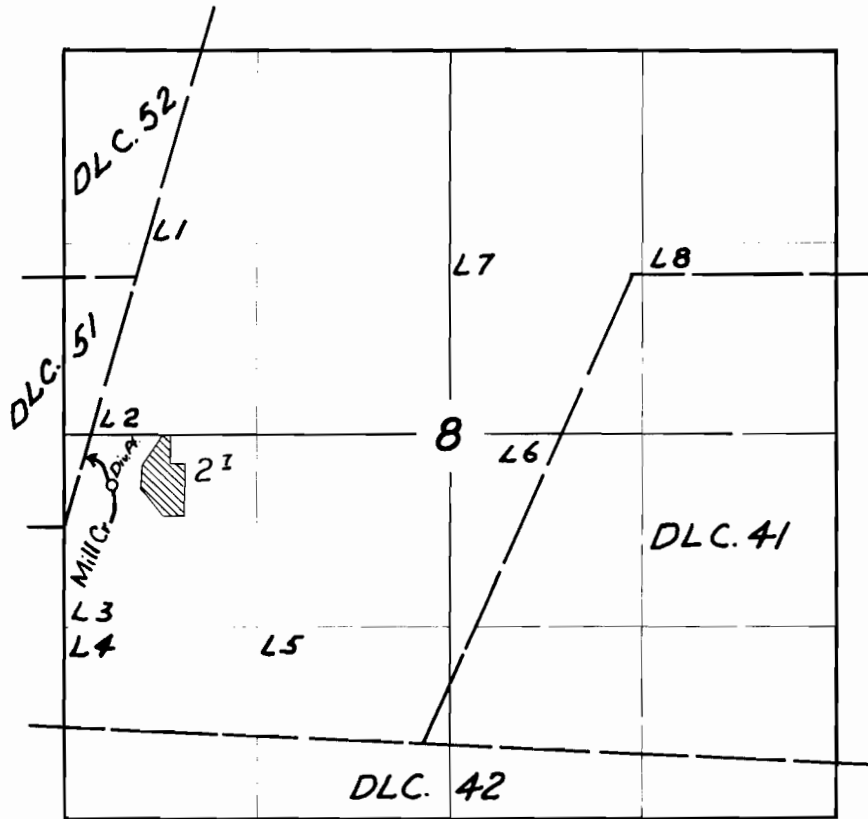

FINAL PROOF SURVEY

UNDER

Application No. 18177 Permit No. 13811

IN NAME OF

Estate of Edmund Monnier

Surveyed 7 Sept. 1956, by M. Bish