


T.2S. R. 4-5E. W.M.

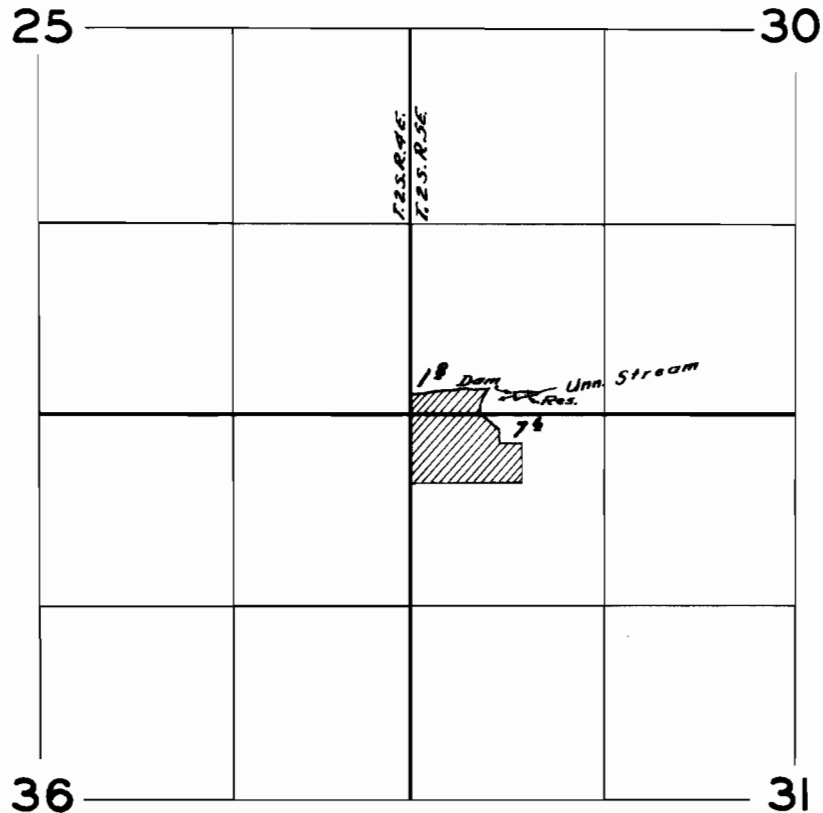

FINAL PROOF SURVEY

UNDER

Application No. ~~R-20048~~ *R-20048* Permit No. ~~R-784~~ *R-784*

IN NAME OF

W. J. BLAKE

Surveyed *June 19, 1956*, by *R.H. Whitby*

DFK-40-82

C.R.