


T. IS. R. 4E. W.M.

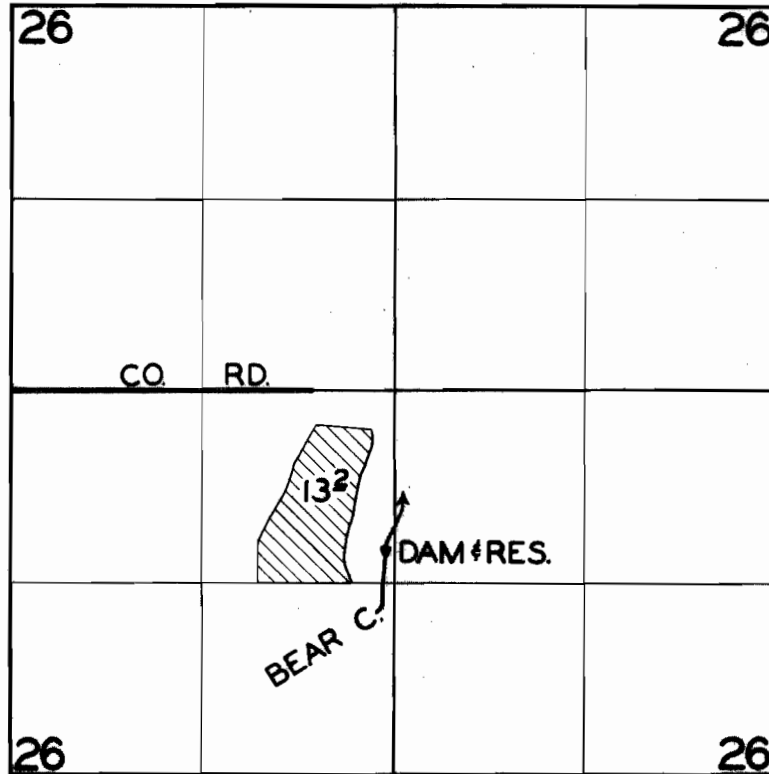

FINAL PROOF SURVEY

UNDER

R-22673

R-895

Application No. **22672** Permit No. **17834**

IN NAME OF

M. C. FLEMING

Surveyed **11 MAY 1956**, by **R.D. BEST**