


T. I. S. R. 2 E. W. M.

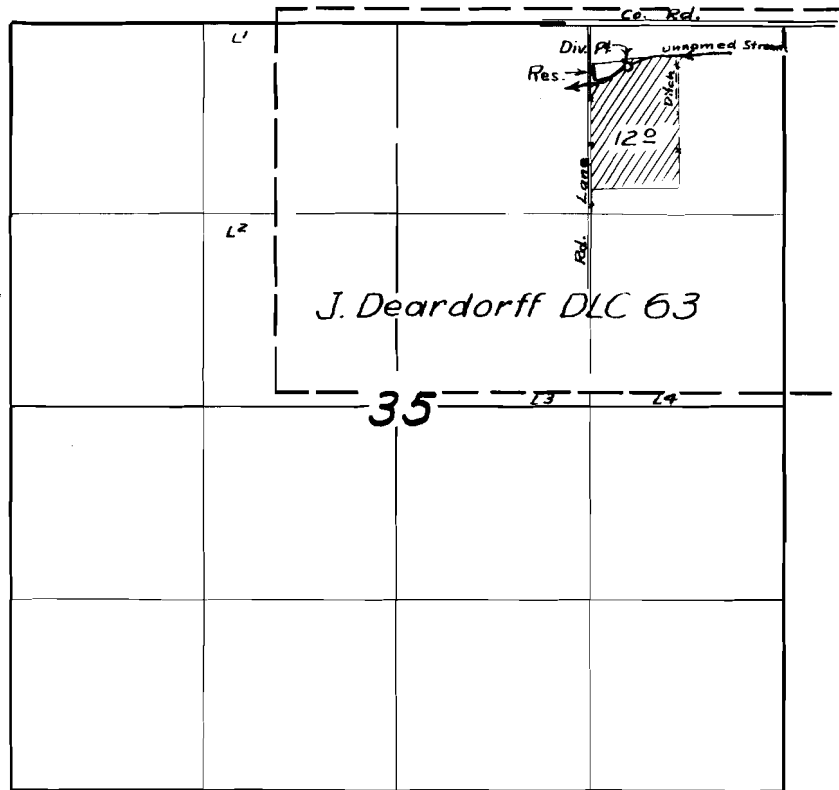

FINAL PROOF SURVEY

UNDER

R-24309

R-1020

Application No. 24310 Permit No. 19340

IN NAME OF

F. Meng

Surveyed 14 May 1956, by Tr. Bish