


T. 4 S. R. 2 W. W. M.

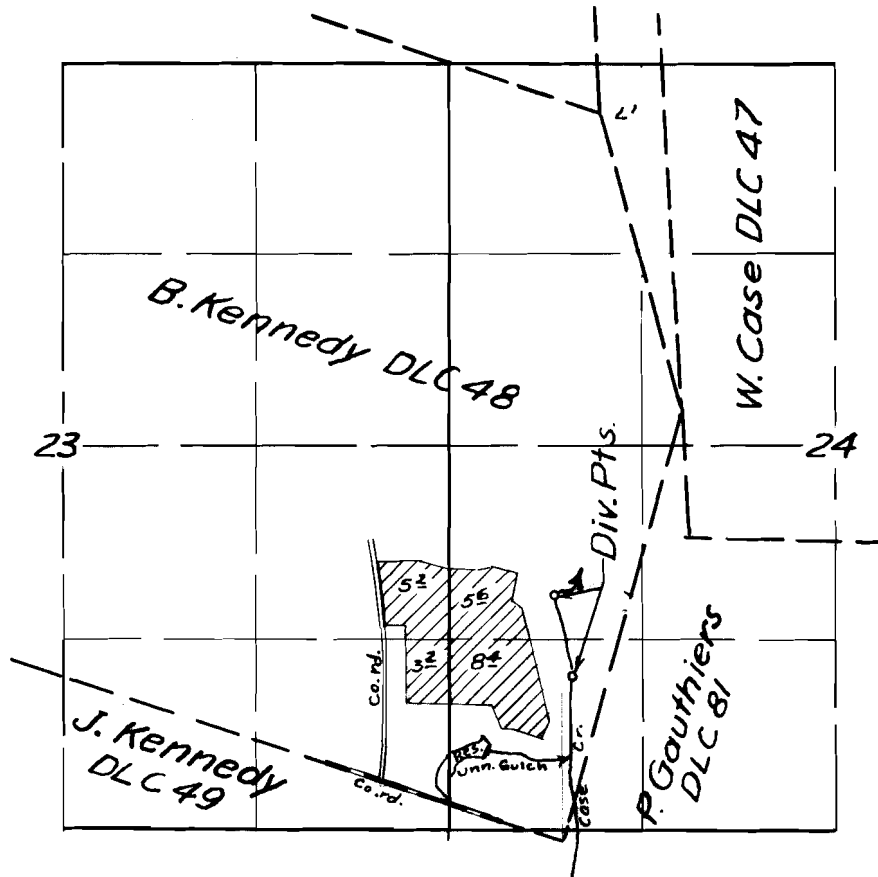

FINAL PROOF SURVEY

UNDER

R-24044

R-1032

Application No. ~~24045~~ Permit No. ~~19440~~

IN NAME OF

Henry Wilmes

Surveyed 6 Sept. 1956, by Tr. Bish