


T. 3 S. R. 3 E. W. M

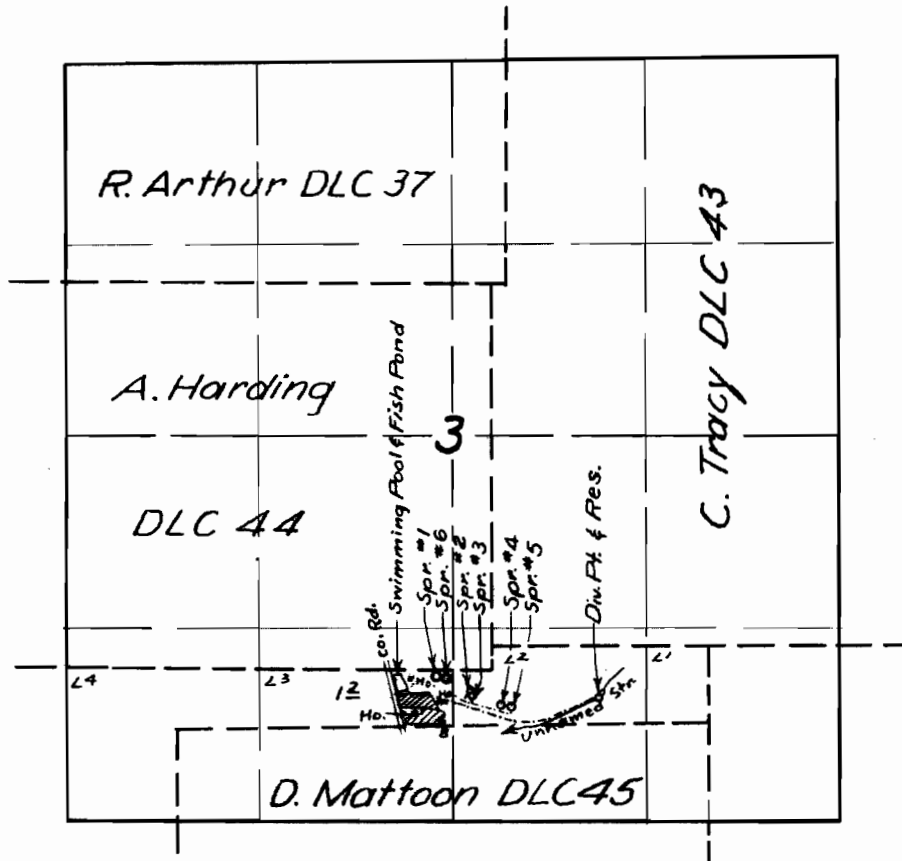

**FINAL PROOF SURVEY**

UNDER

Application No. *R-24768* *24769* Permit No. *R-1057* *19066*...

IN NAME OF

*Estate of Alfred P. Waer*

Surveyed *30 Aug 1956*, by *J. B. Bish*