


T. 7 S. R. 1 W. W.M.

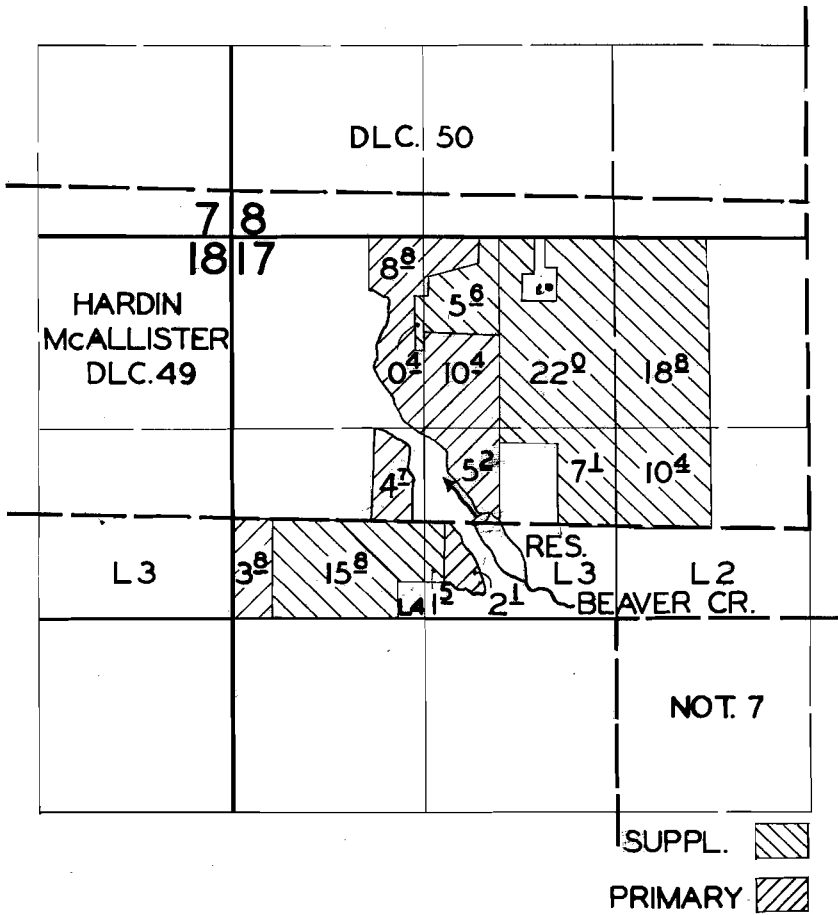

FINAL PROOF SURVEY

UNDER

R-25533

~~R-1140~~

R-1149

Application No. 25534 Permit No. 20222

IN NAME OF

HERMAN KUENZI, PAUL STAEDEL & BEN KAUFMAN

Surveyed 15 APR. 1956, by M. BISH

(WPS)