


T. 2 S. R. 5 E. W. M.

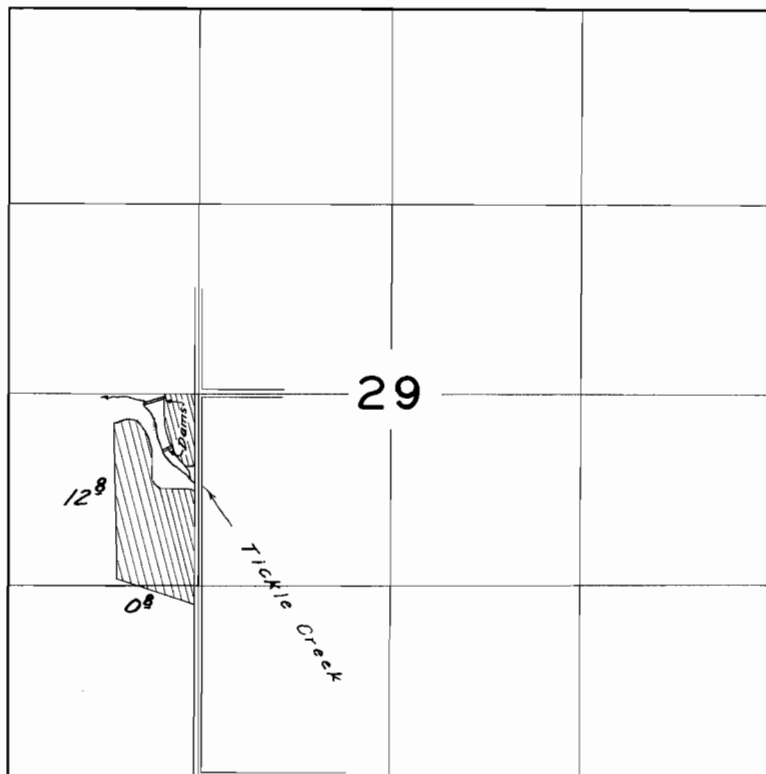

FINAL PROOF SURVEY

UNDER

Application No. *R-25844* *R-1164*
25845 Permit No. *20300*
IN NAME OF

Andrew C. Reckman

Surveyed *June 18 1956*, by *R.H. Whitby*

DEK-16-76
Pantograph

C.B.