


T.6 S. R. I. E. W. M.

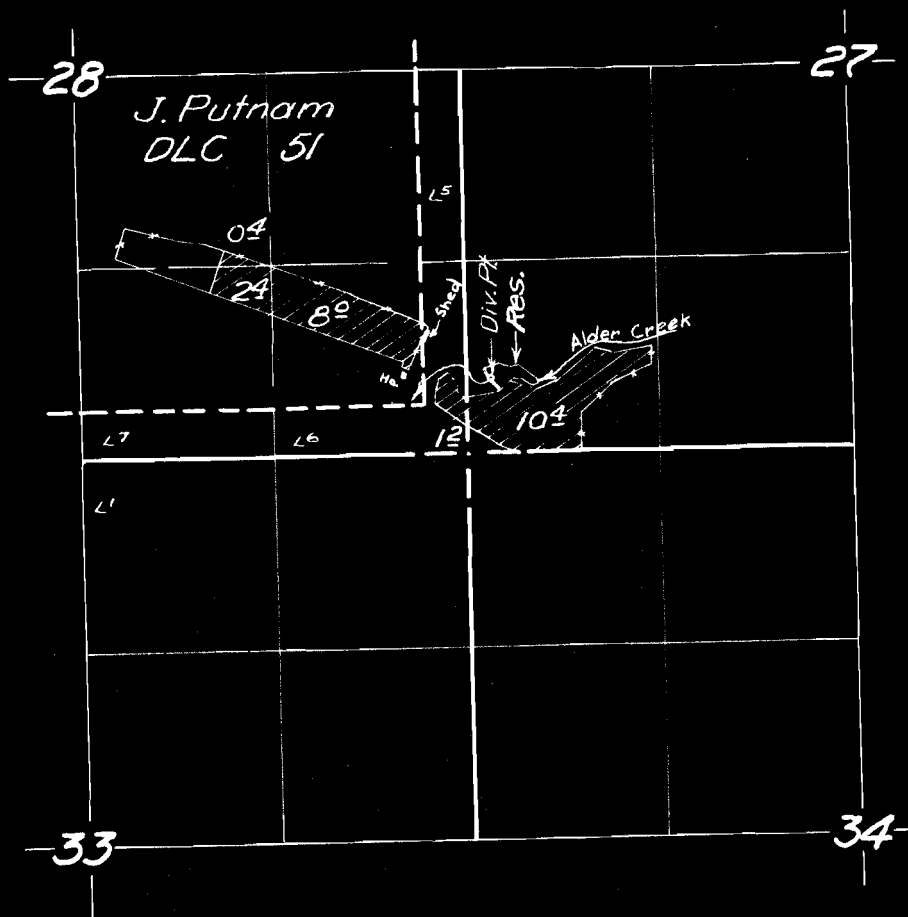

FINAL PROOF SURVEY

UNDER

Application No. *R-25698* Permit No. *R-1207*
25699

IN NAME OF

J. N. Jacobsen

Surveyed *7 Aug.* 1956, by *M. Bish*