


T.6 S. R. I. E. W. M.

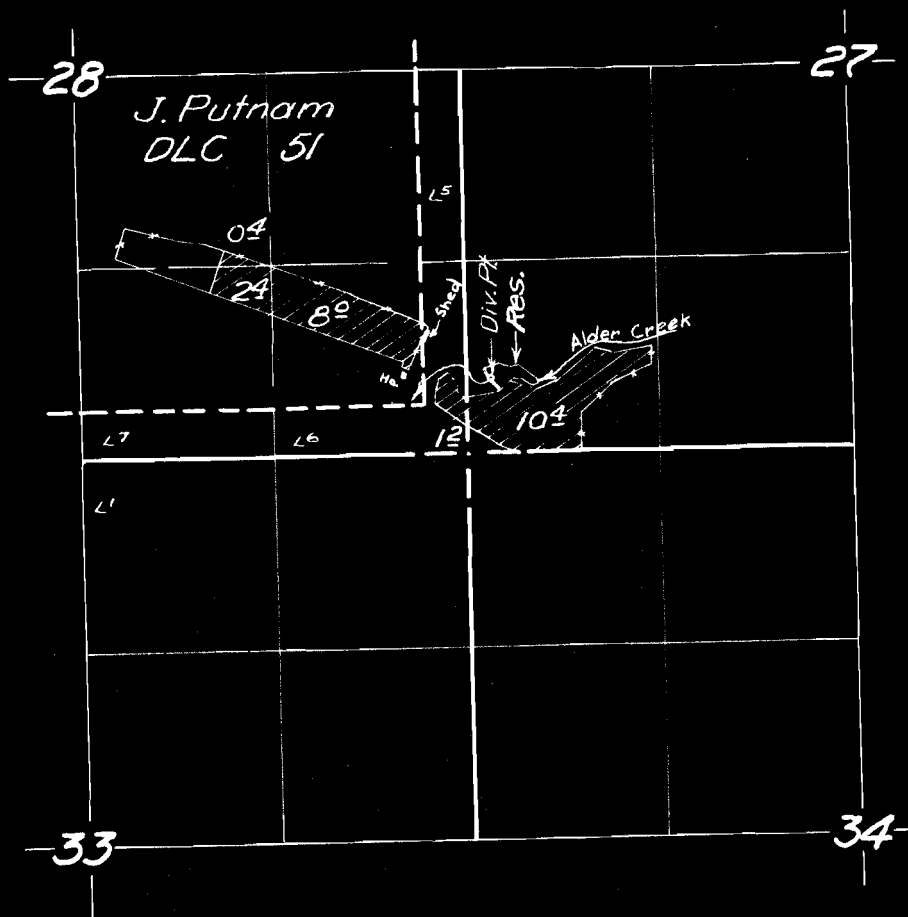

FINAL PROOF SURVEY

UNDER

Application No. *R-25698* *25699* Permit No. *R-1207* *20518*

IN NAME OF

*J. N. Jacobsen*

Surveyed *7 Aug.* 1956, by *M. Bish*