


T. 4S. R. 4E. W.M.

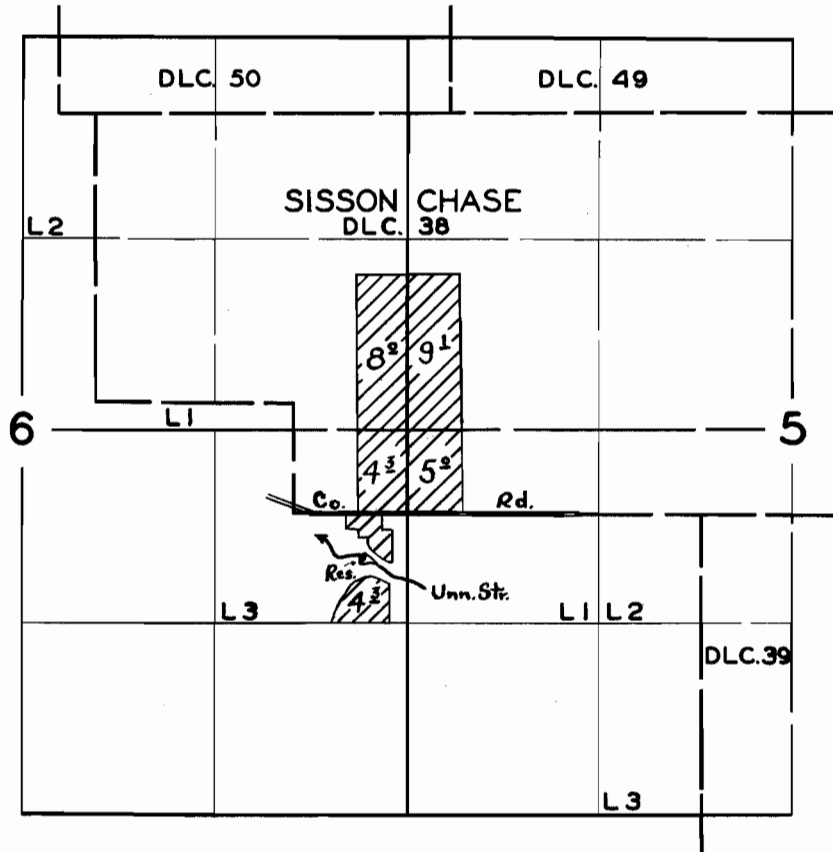

FINAL PROOF SURVEY

UNDER

R-26458

R1279

Application No. **26459** Permit No. **20859**

IN NAME OF

WILBUR W. HOWELL

Surveyed **4 APR. 1956**, by **R. D. BEST**

REV