


T. 4S. R. 4E. W.M.

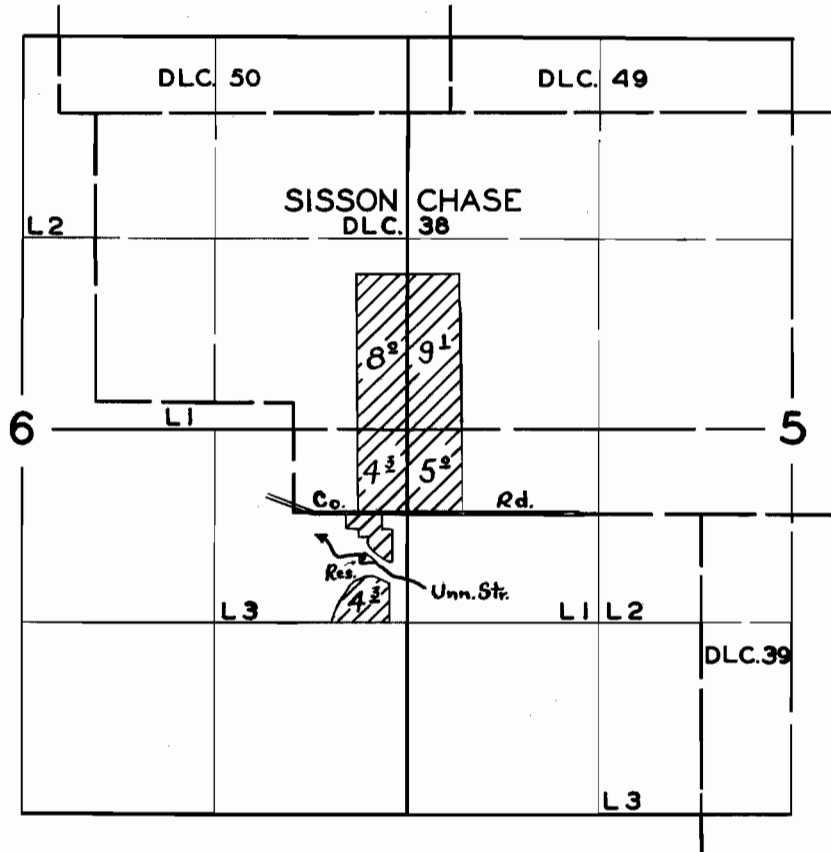

**FINAL PROOF SURVEY**

UNDER

*R-26458*

*R1279*

Application No. **26459** Permit No. **20859**

IN NAME OF

**WILBUR W. HOWELL**

Surveyed **4 APR. 1956**, by **R. D. BEST**

*RB*