


T.2S.R.1E.W.M.

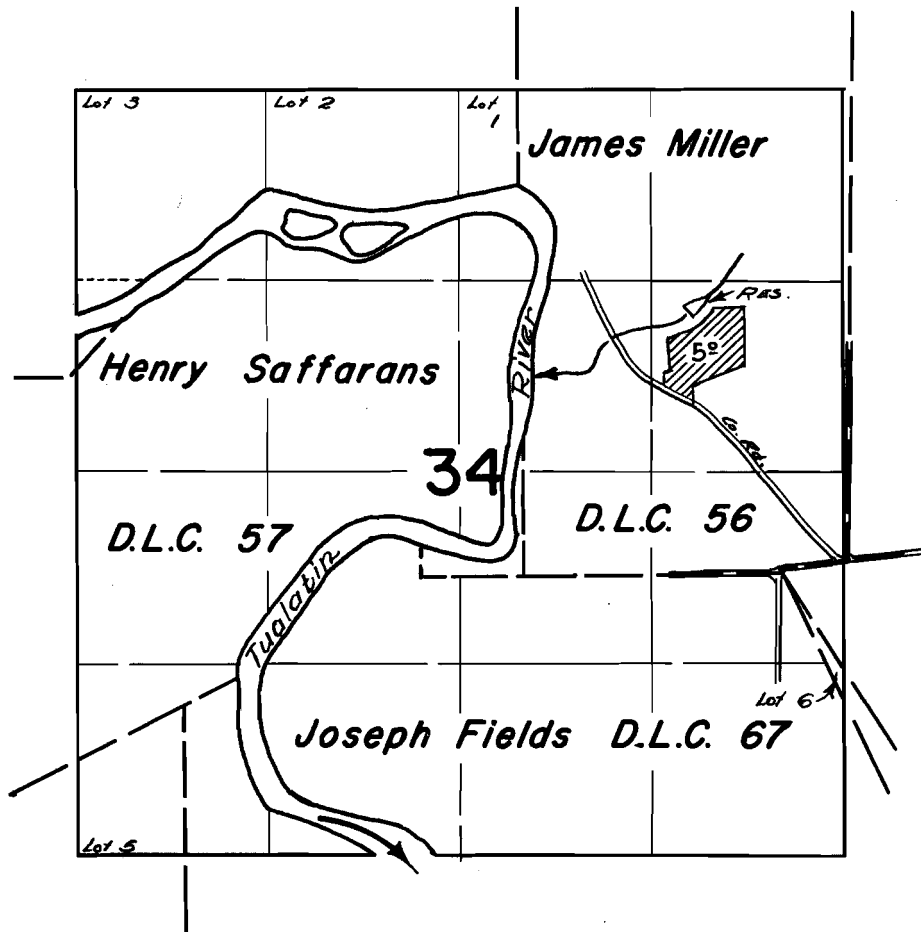

FINAL PROOF SURVEY UNDER

R-27121 R-1360
Application No. 27122 Permit No. 21335
IN NAME OF

NATHAN O. WRIGHT

Surveyed *May 7, 1956*, by *R.D. Best*.