
T. 2 S. R. 3 E.W.M.

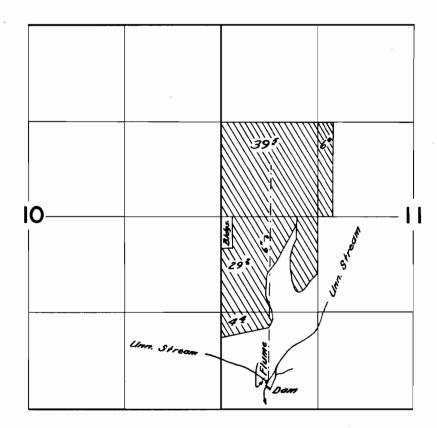

FINAL PROOF SURVEY

UNDER

| Application No. 278.55. Permit No. 219.54. IN NAME OF |
|---|
| Carl France |
| Surveyed June 27 10 64 by P. W. J. William |

DFK-10-163