T. 2 S. R. 3 E. W. M.

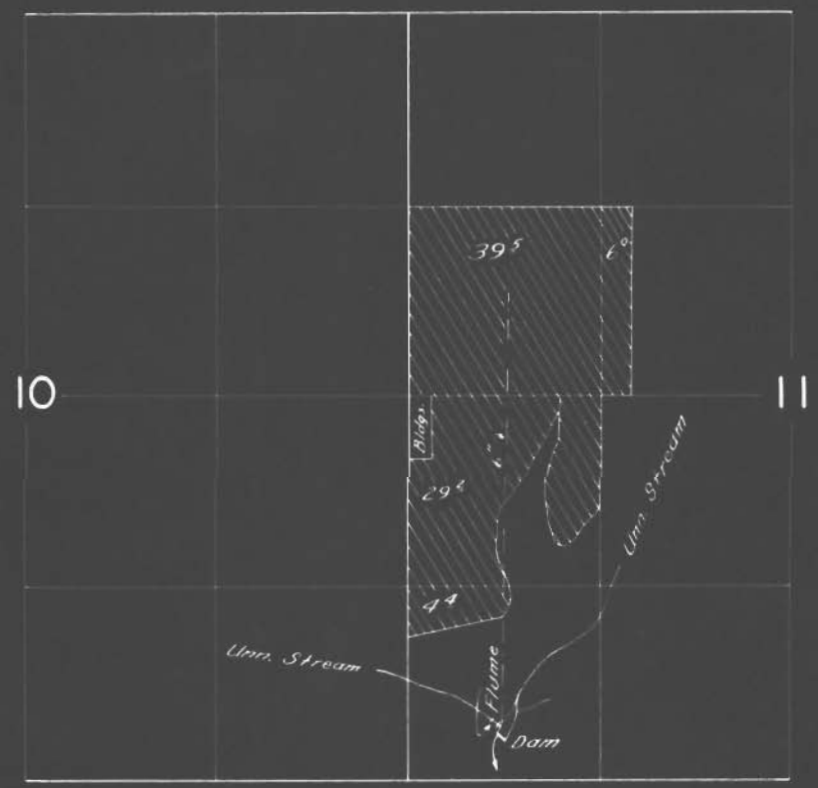

FINAL PROOF SURVEY

UNDER

R-28014 R-1469
Application No. 27855 Permit No. 21954

IN NAME OF

Carl France

Surveyed June 27 1956 by R. H. Whitby

DFR 13-163

C.B.