


T. 2 S. R. 3 E. W. M.

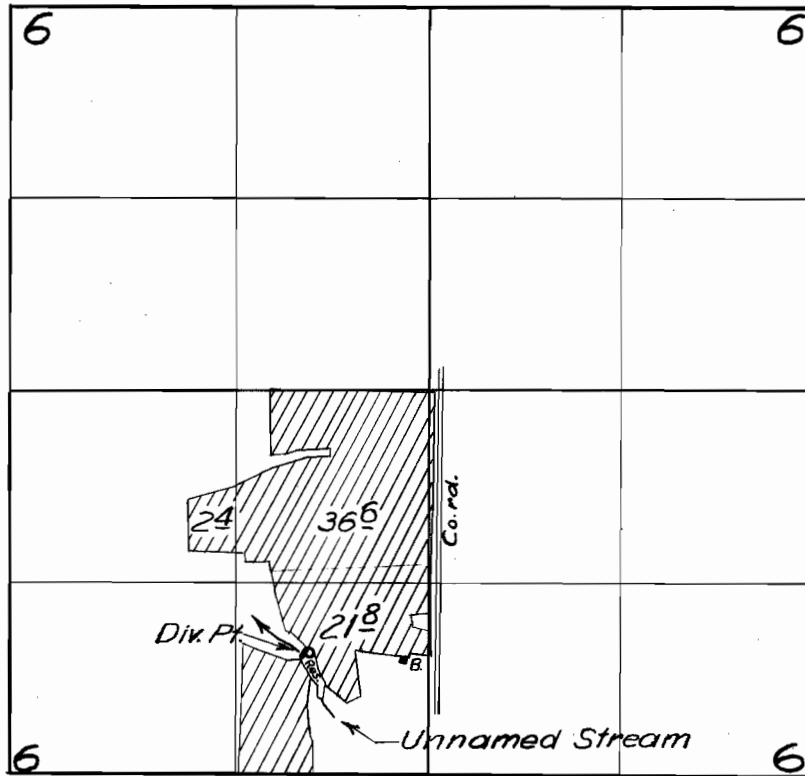

FINAL PROOF SURVEY

UNDER

Application No. ^{R 26374} ~~26375~~ ... Permit No. ^{R 1511} ~~22415~~ ...

IN NAME OF

..... *Stockton Paulson*

Surveyed *30 Aug.* 1956, by *T. M. Bish*