


T. 2 S. R. 3 E. W. M.

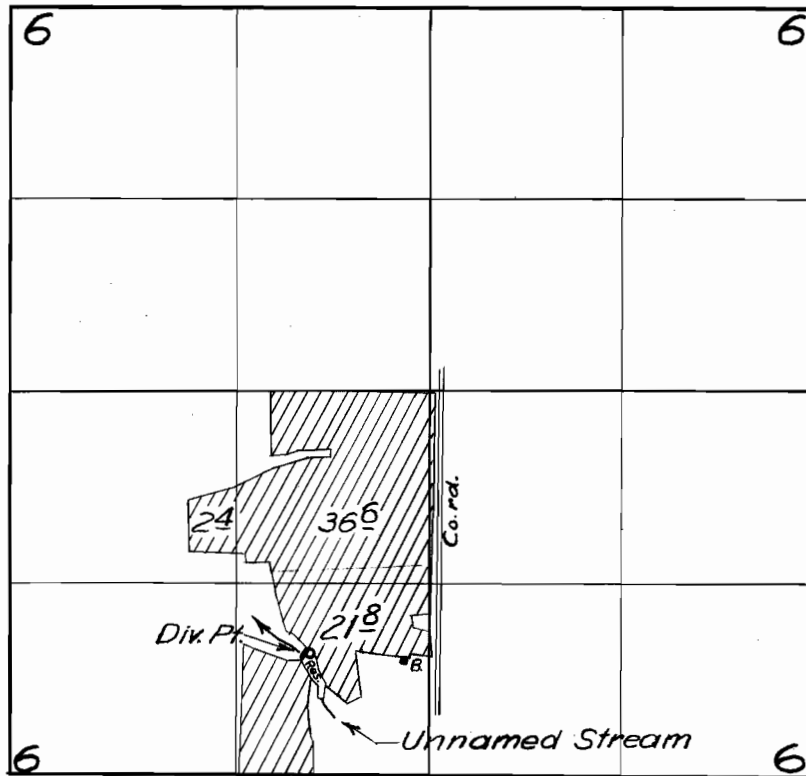

FINAL PROOF SURVEY

UNDER

Application No. ^{R 26374} 26375... Permit No. ^{R 1511} 22415...

IN NAME OF

Stockton Paulson

Surveyed 30 Aug. 1956, by Tr. Bied