


T.1 S. R.3 E.W.M.

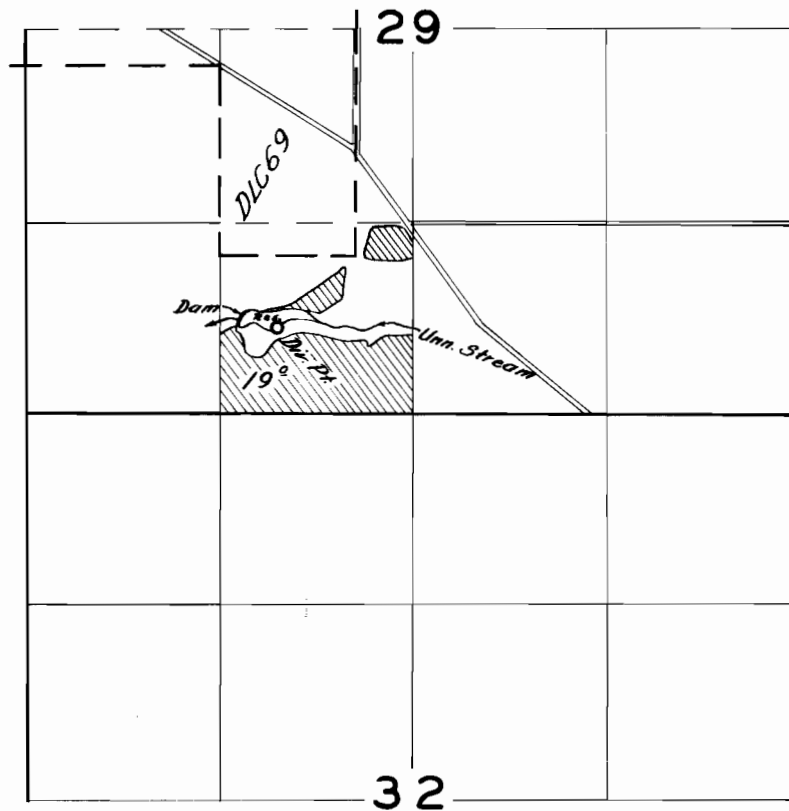

FINAL PROOF SURVEY

UNDER

Application No. *R-28590* ~~28591~~ Permit No. *R-1598* ~~22815~~
IN NAME OF

J. A. RYAN

Surveyed *June 26* 1956, by *R. H. Whitby*