


T. 1 S. R. 3 E. W. M.

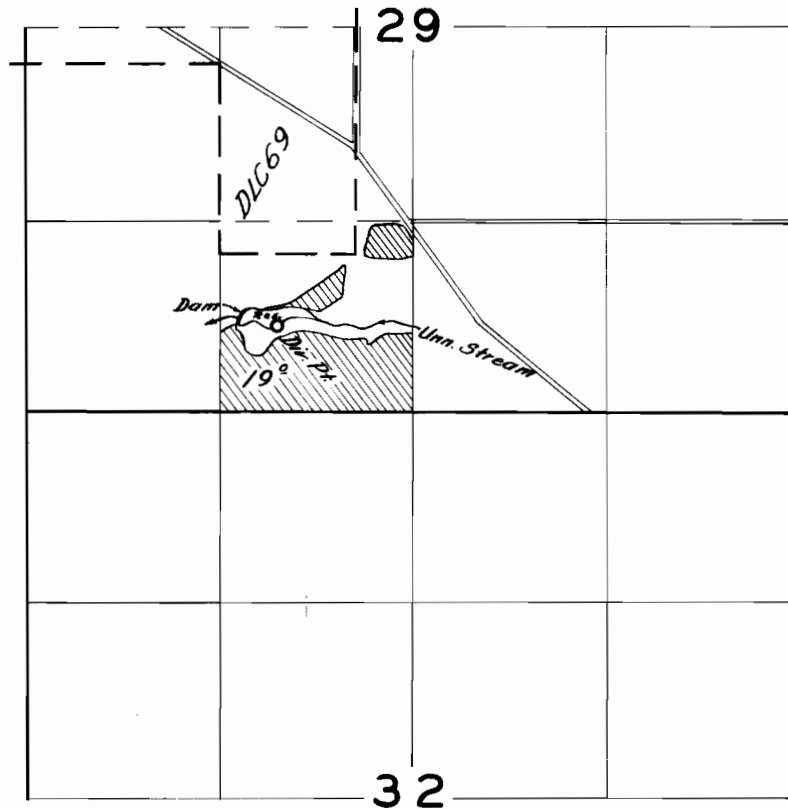

FINAL PROOF SURVEY

UNDER

Application No. *R-28590* ~~28591~~ Permit No. *R-1598* ~~22813~~
IN NAME OF

J. A. RYAN

Surveyed *June 26*, 1956, by *R. H. Whitby*