


T. 7 N. R. 2 W. W. M.

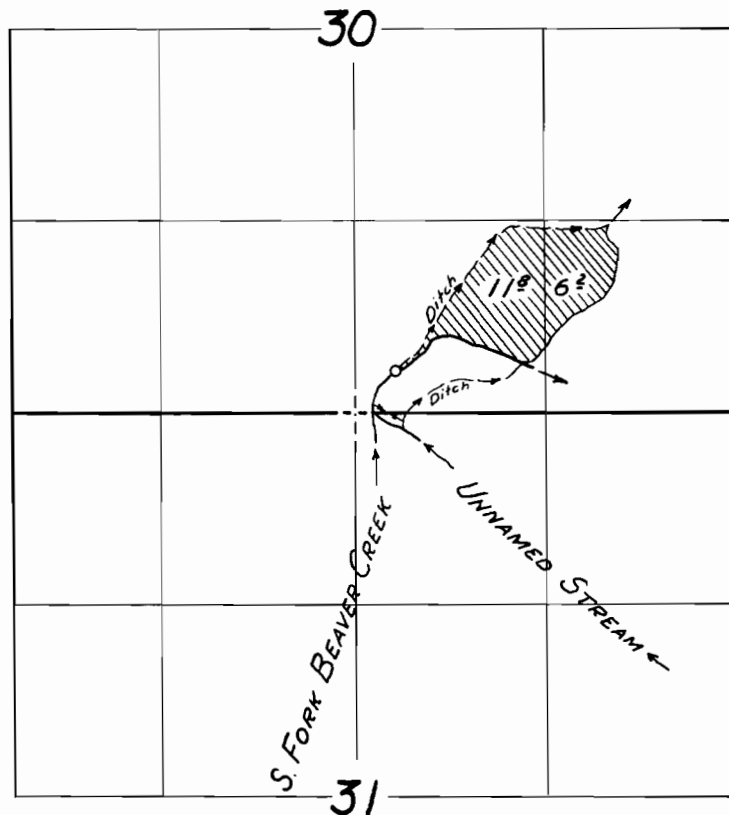

FINAL PROOF SURVEY
UNDER

Application No. 18482 Permit No. 14153
IN NAME OF

EVERETT L. SKEANS

Surveyed 21 Aug 1956, by *R. H. Kelley*