


T. 6 N. R. 6 W. W. M.

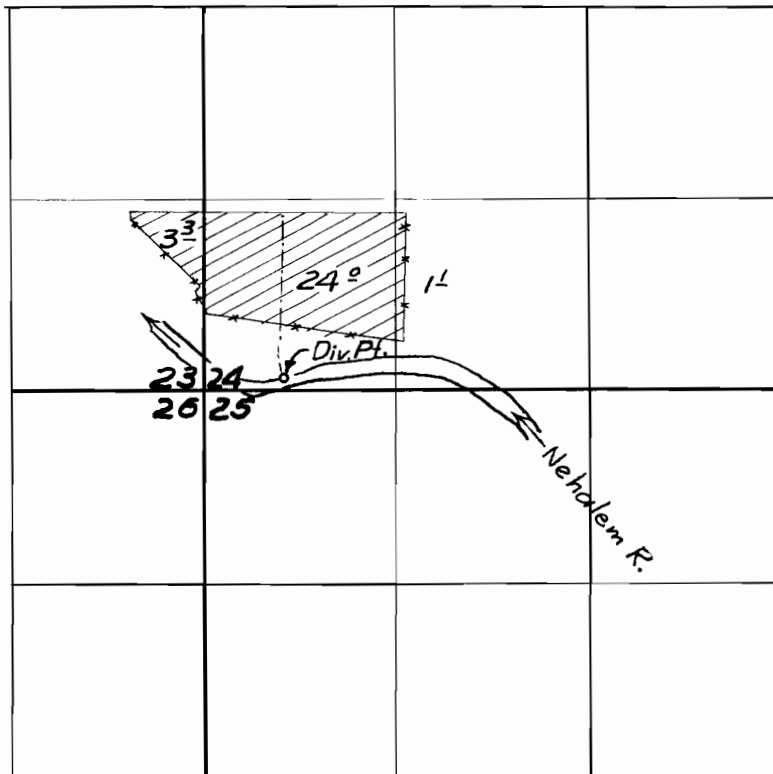

FINAL PROOF SURVEY

UNDER

Application No. 18567... Permit No. 14186...

IN NAME OF

Victor & Grace Berg

Surveyed 17 Aug. 1956, by *M. Bishop*