


T. 1 N., R. 3 W., W.M.

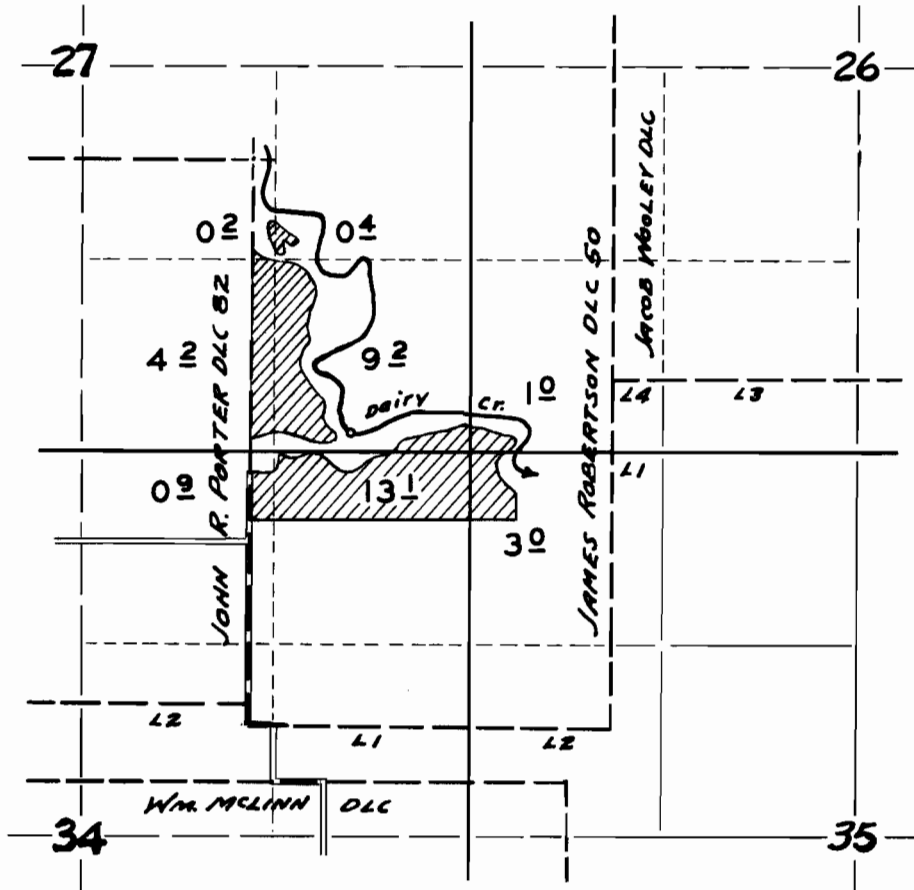

FINAL PROOF SURVEY
UNDER

Application No. 18653 Permit No. 14285
IN NAME OF

J. G. KRAFT

Surveyed 4-24-1956, by R.H. WHITBY.