


T.1N. R. 4E. W.M.

COLUMBIA RIVER

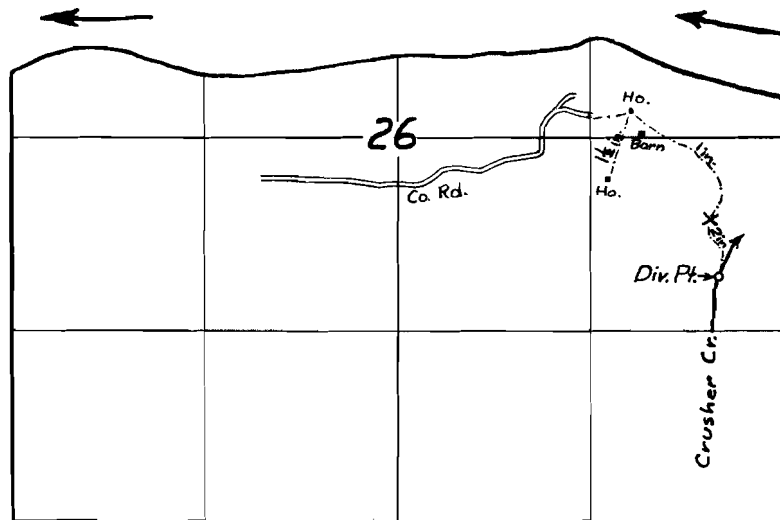

FINAL PROOF SURVEY
UNDER

Application No. 19286... Permit No. 15004...
IN NAME OF

Minnie T. Reed

Surveyed 27 Aug. 1956, by Tom Bishop