


T. 2 S., R. 1 & 2 W., W. M.

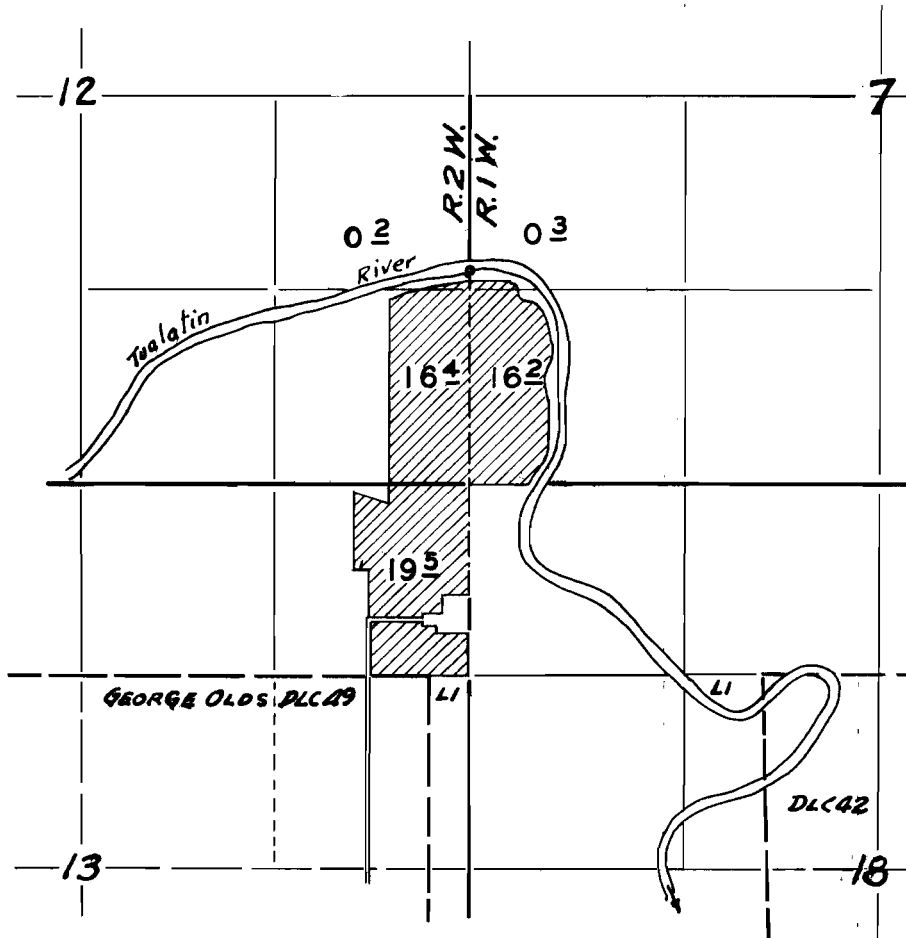

FINAL PROOF SURVEY

UNDER

Application No. 19483 Permit No. 15097

IN NAME OF

CHARLES T. GRACE

Surveyed 5 - 8 1956, by M. BISH