


T. 4&5S. R. 1W. W.M.

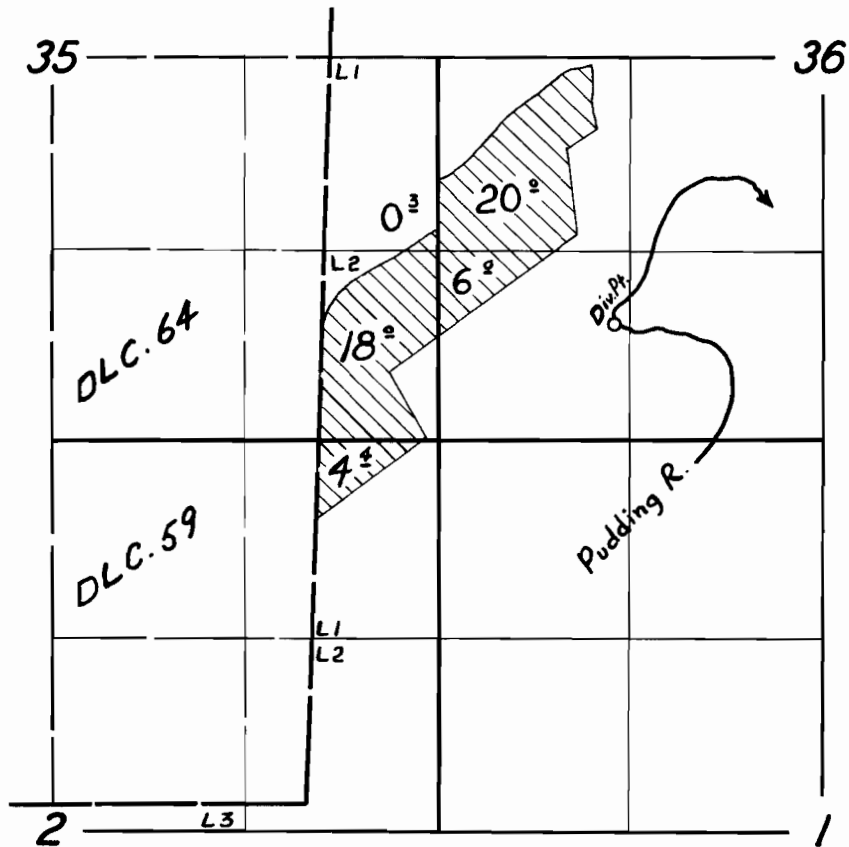

FINAL PROOF SURVEY

UNDER

Application No. 19567 Permit No. 15150

IN NAME OF

C.A. & F.M. CARLSON

Surveyed 19 Sept. 1956, by M. Bish

DFN-2D-79

205