


T.2 S. R.3 E.W.M.

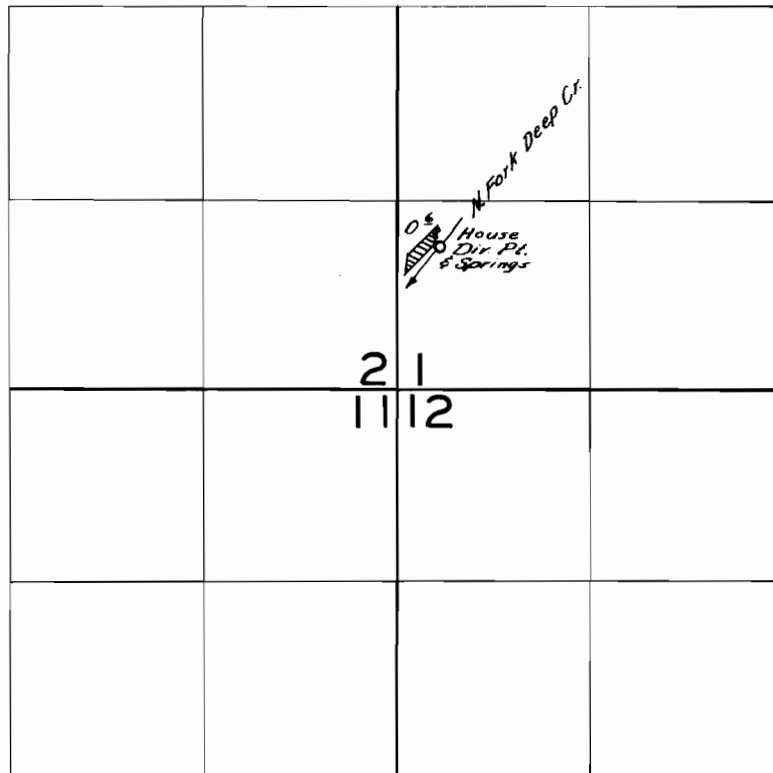

FINAL PROOF SURVEY

UNDER

Application No. *19809* Permit No. *15391*.....

IN NAME OF

William J. Powers & Harvey G. Sisson

Surveyed *June 23* 1956, by *R.H. Whitby*.....

DFK-5D-17