


T. 8 S. R. 44 E. W. M.

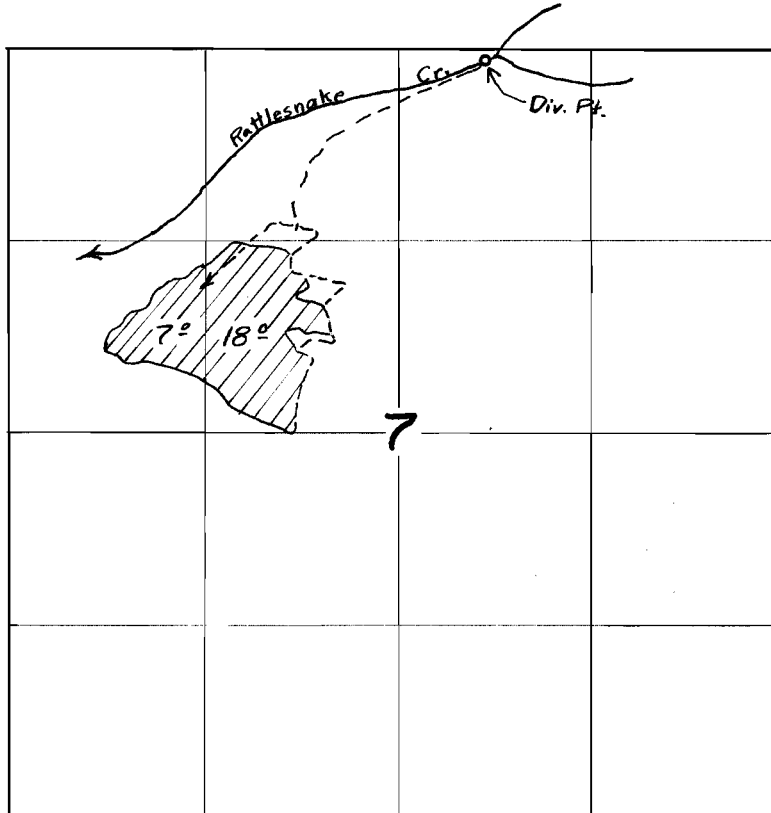

FINAL PROOF SURVEY
UNDER

Application No. 19981 Permit No. 15546
IN NAME OF

Dennis Butterfield

Surveyed 29 May 1956, by M. Bish