


T.1S.R.4E.W.M.

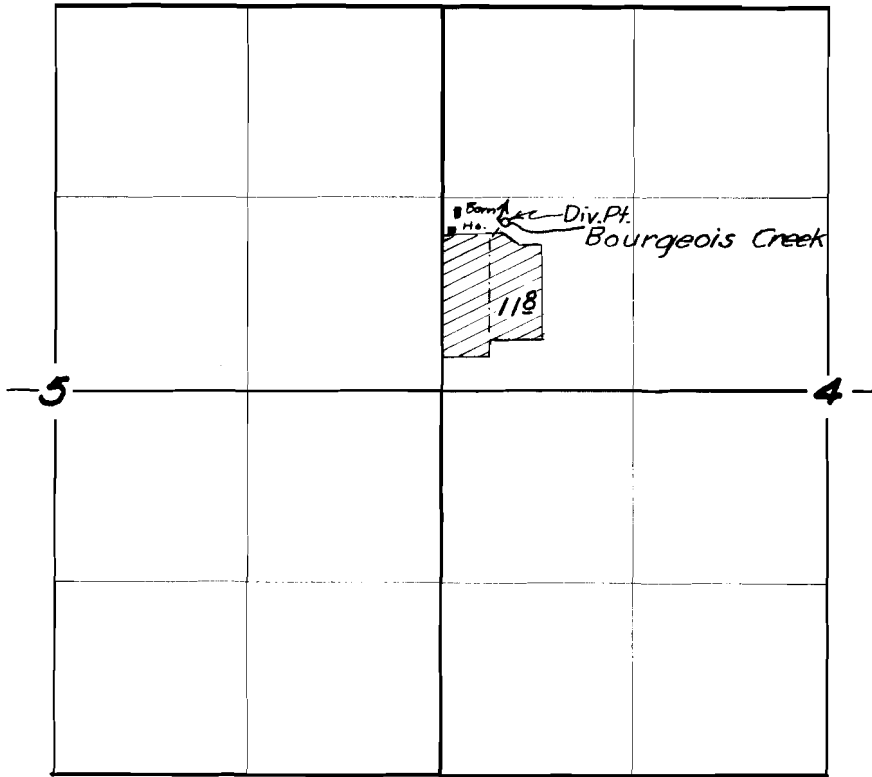

FINAL PROOF SURVEY
UNDER

Application No. *20479*... Permit No. *15990*...
IN NAME OF

Ralph D. Christensen

Surveyed *27 July 1956*, by *M. Bish*