


T. 2 S. R. 6 E. W. M.

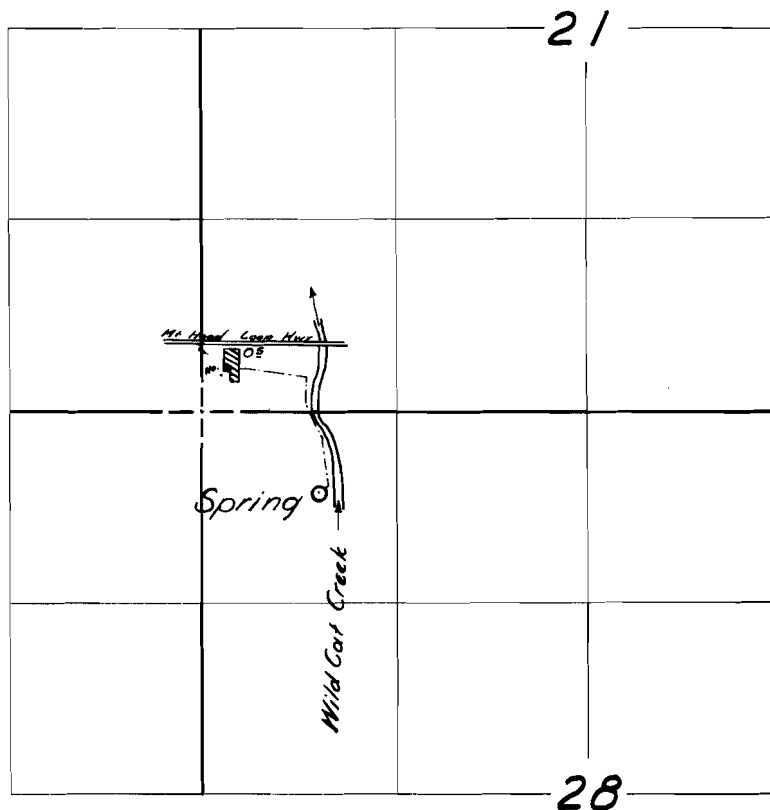

FINAL PROOF SURVEY

UNDER

Application No. 20475 Permit No. 16068

IN NAME OF

ELMER G. & MARJORIE E. ALLEN

Surveyed 20 June 1956 by C. A. Kibbey