


T.1S. & 1N. R. 10W. W.M.

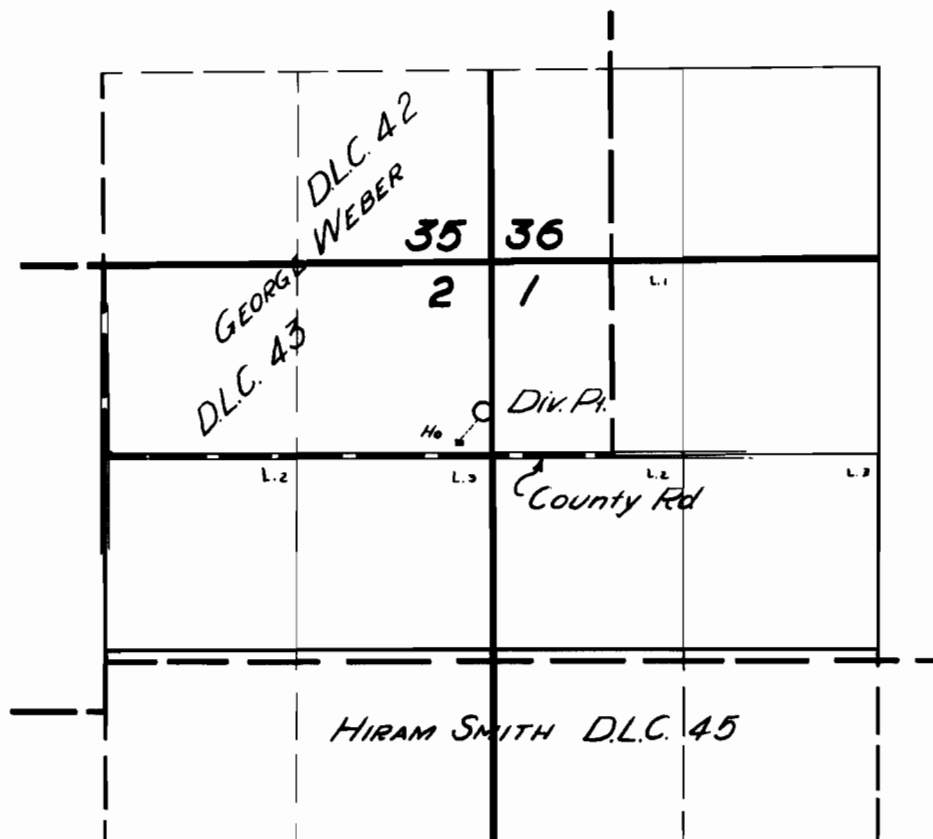

FINAL PROOF SURVEY
UNDER

Application No. 20526 Permit No. 16069
IN NAME OF

Winona Harkey

Surveyed 13 July 1955, by T. JONES

1955-Z