


T 9 S. R. 2 W. W. M.

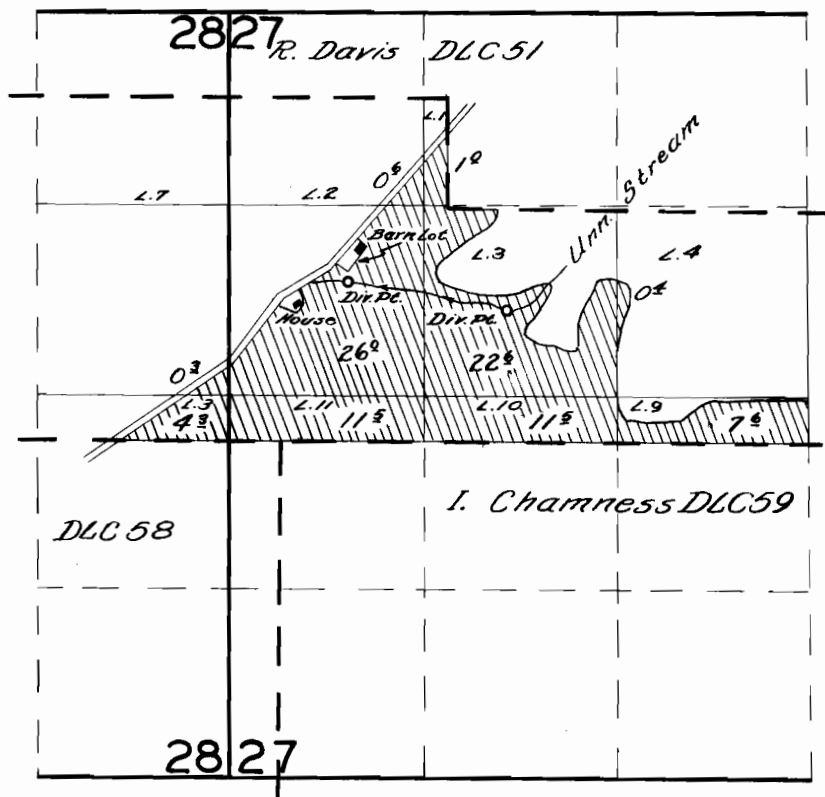

FINAL PROOF SURVEY

UNDER

Application No. 20945 Permit No. 16402
IN NAME OF

Dewey & Lillian Peterson

Surveyed April 20 1956, by R.K. Whitby

DFN-20-52