


14

TOWNSHIP 39S, RANGE 1W., W. M.

North

Scale: 1" = 660'

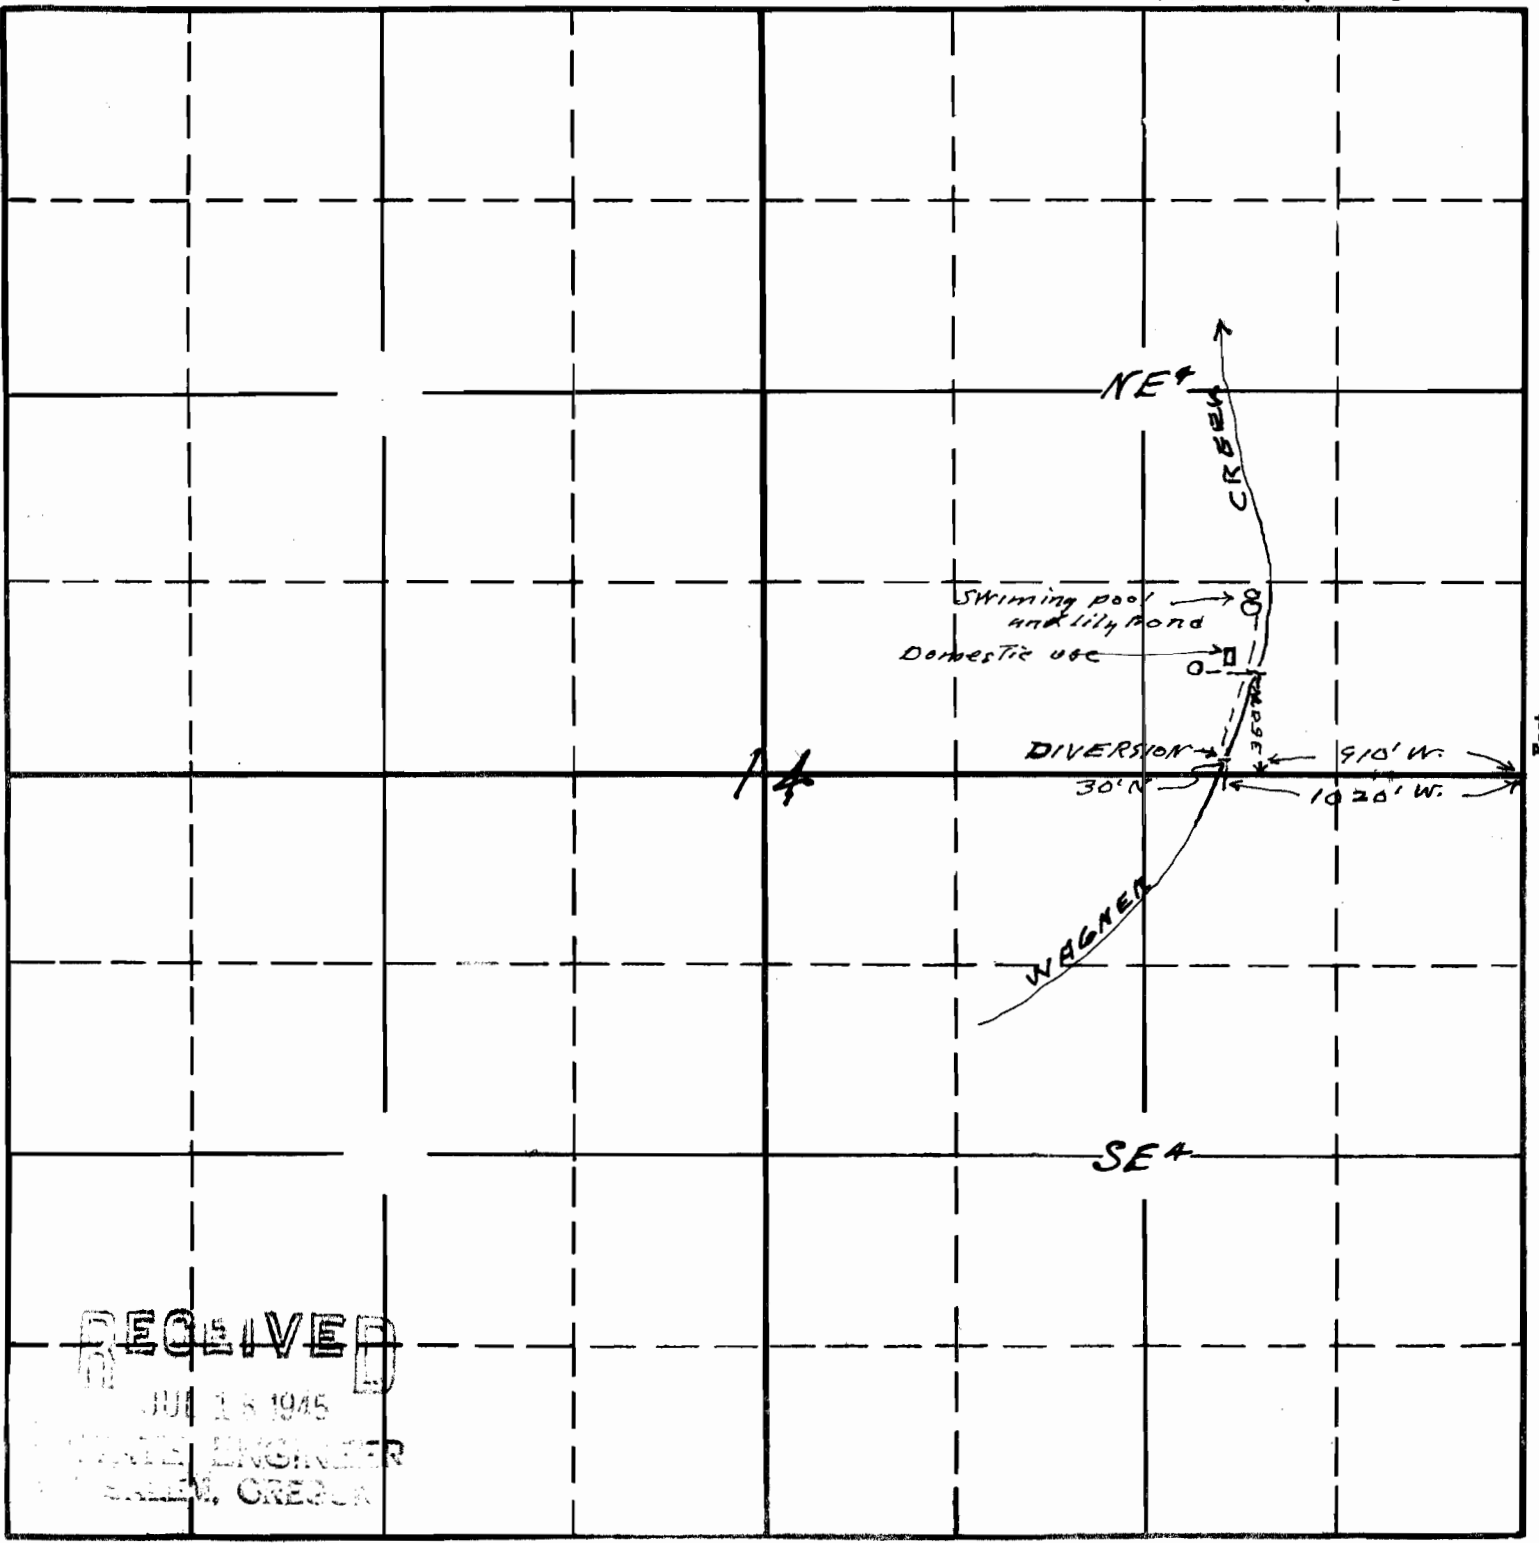

RECEIVED
 JUL 28 1945
 STATE ENGINEER
 SALEM, OREGON

South

20972
15-23

APPLICATION No. 20972

PERMIT No. 16418

Map to accompany application of
 I. N. Shultz for use of waters of
 pool and lily pond purposes

This office 6/28/45 *[Signature]*