


T. 2 S. R. 6 E. W. M.

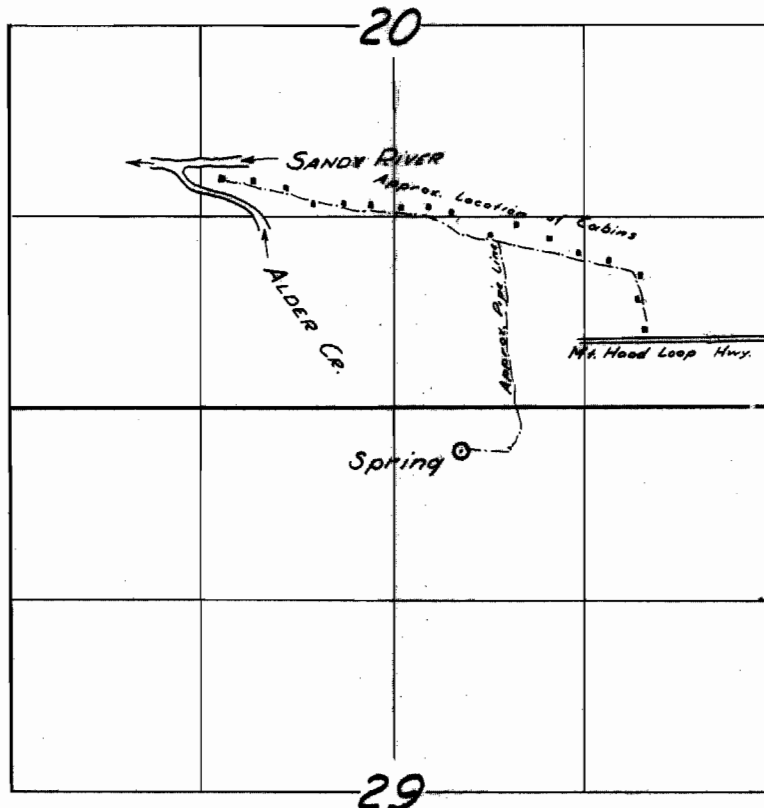

FINAL PROOF SURVEY
UNDER

Application No. 20800 Permit No. 16460
IN NAME OF

E. W. MORLAN

Surveyed 21 June 1956, by [Signature]