


T.23S. R.5W.W.M.

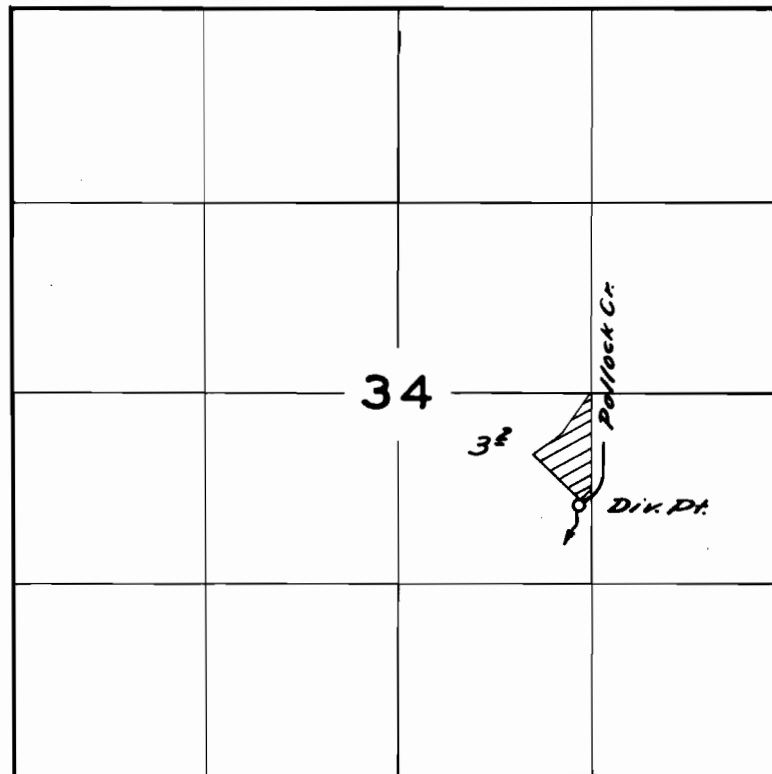

FINAL PROOF SURVEY
UNDER

Application No. *21176* Permit No. *16595*
IN NAME OF

P. O. Green

Surveyed *July 18* 19*56*, by *C. O. Bartels*