


T. 9 S. R. 1 W. W. M.

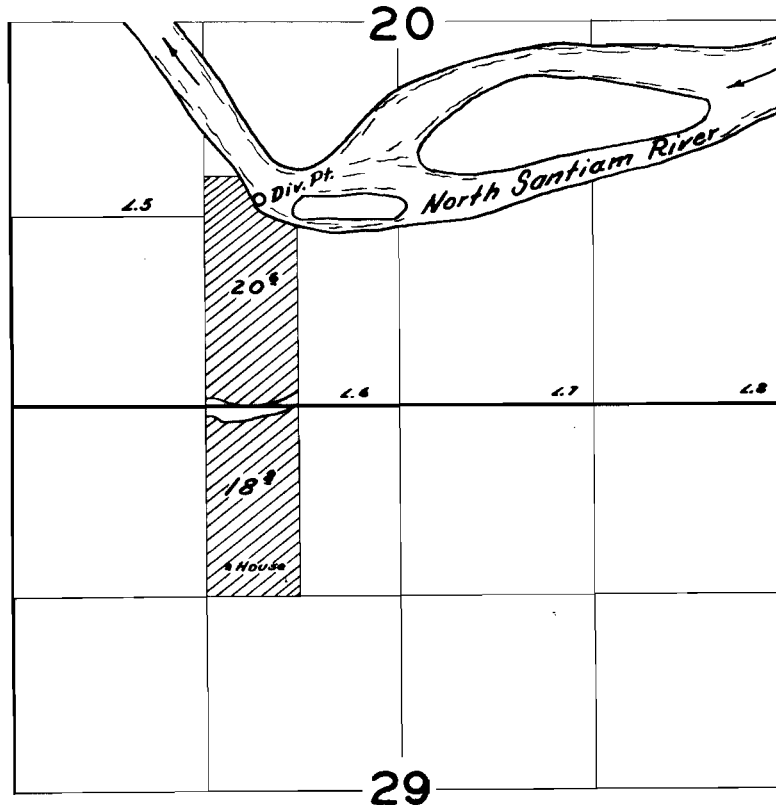

FINAL PROOF SURVEY

UNDER

Application No. *21618* Permit No. *16987*

IN NAME OF

WARD NATION

Surveyed *July 26, 1956*, by *C.O. Bartels*