


T. 2 S., R. 1 W., W. M.

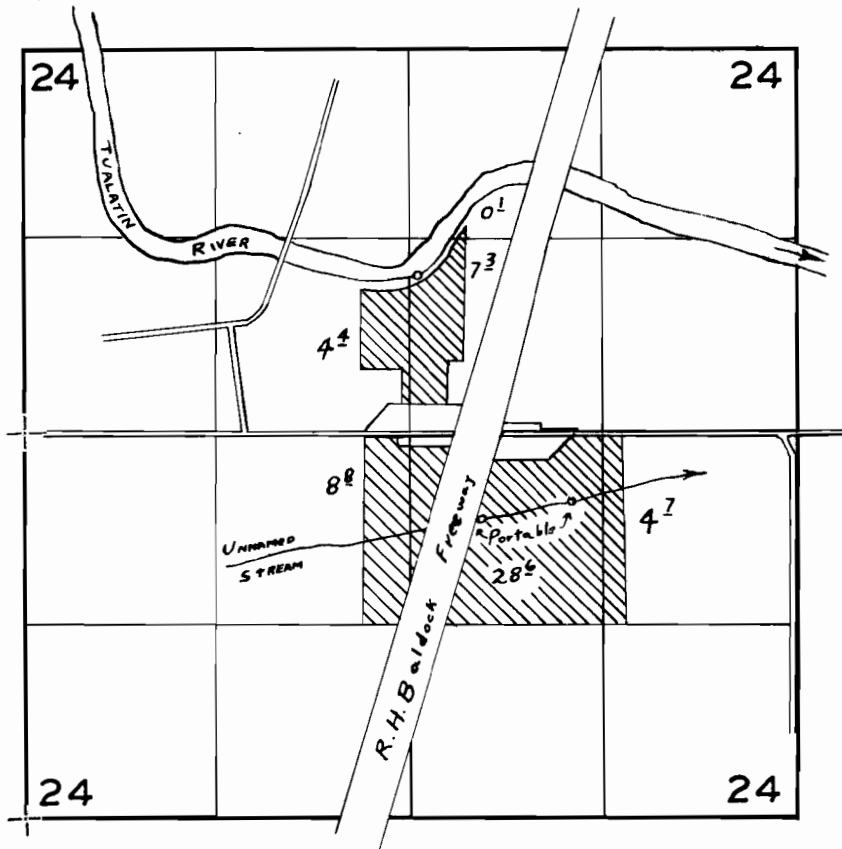

FINAL PROOF SURVEY

UNDER

Application No. 22436 Permit No. 17678

IN NAME OF

CLAYTON NYBERG

Surveyed 5 - 7 1956, by R.H. WHITBY