


T. 4S. R. 2E. W.M.

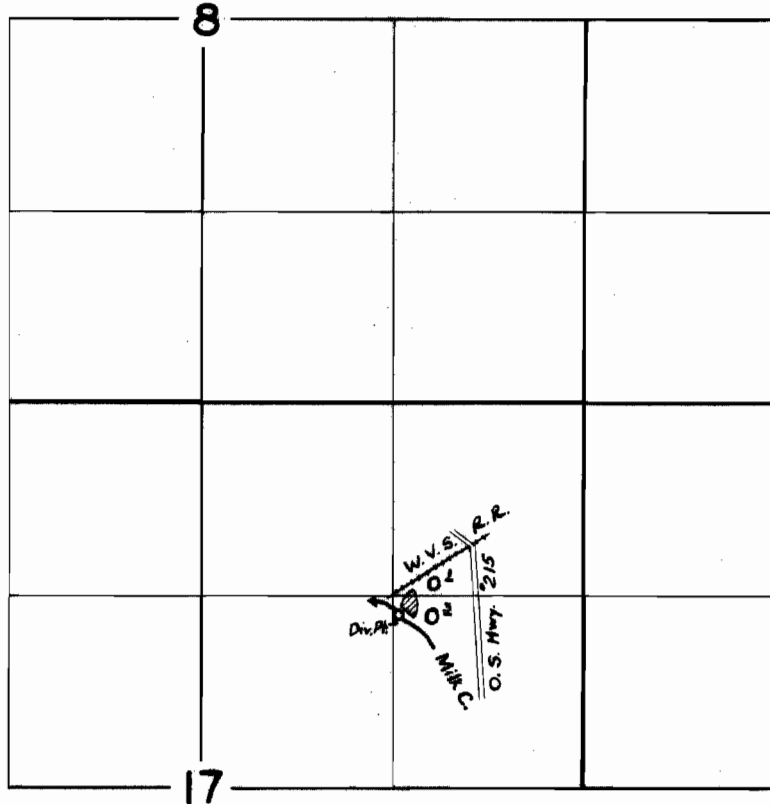

FINAL PROOF SURVEY

UNDER

Application No. 22513 Permit No. 17879

IN NAME OF

FLOYD E. & CAROLINE L. BOLKIN

Surveyed 12 MAR, 1956, by R.D. BEST