


T. 3S. R. 1W. W.M.

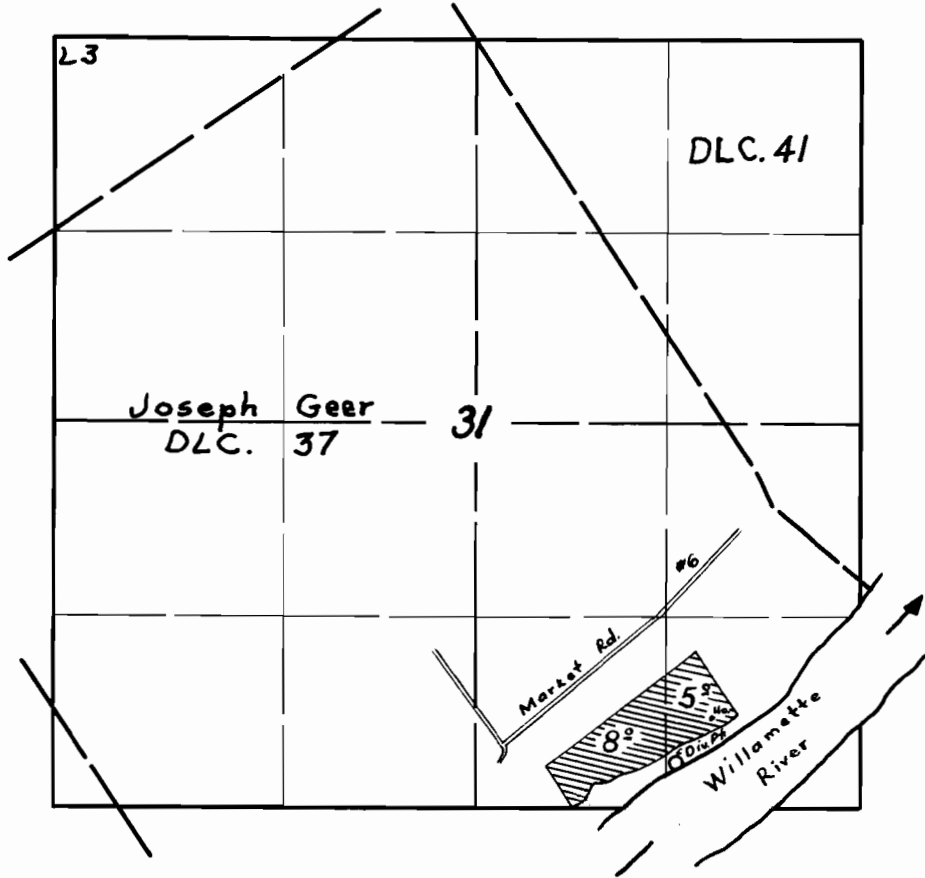

FINAL PROOF SURVEY
UNDER

Application No. 22454 Permit No. 18015
IN NAME OF

BERTHA P. SINGER

Surveyed 29 June 1956, by M. Bish

DFK-2D-43

200