


T. 3S. R. 2E. W.M.

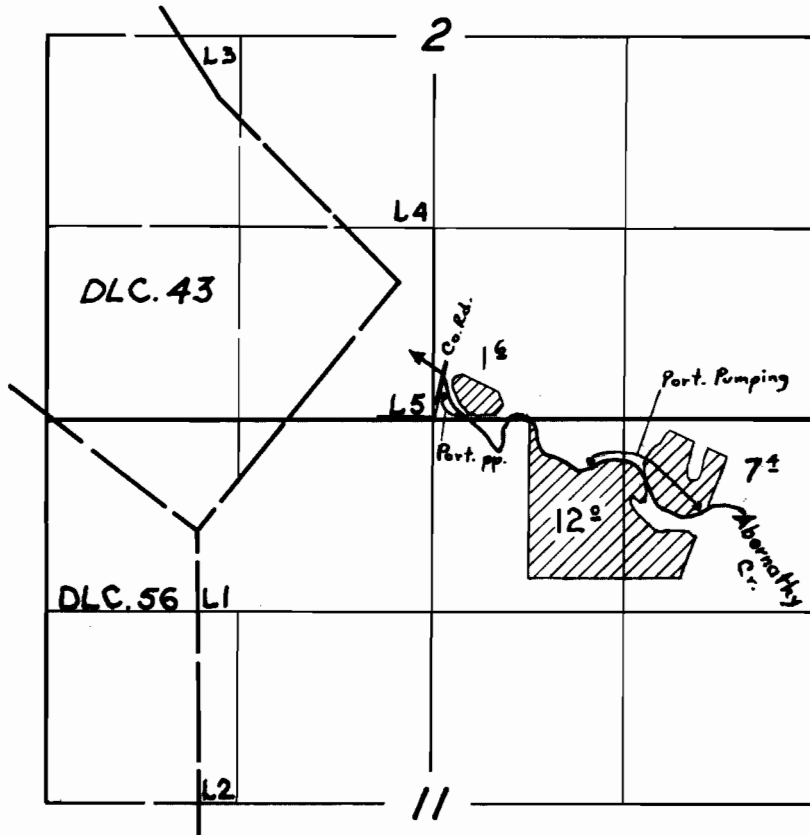

FINAL PROOF SURVEY
UNDER

Application No. 22917 Permit No. 18067
IN NAME OF

LOUIS R. COPLEY

Surveyed 19 June 1956, by M. Bish

DFK-1D-41

Ret 79