


T. 6 N R. 2 W W.M.

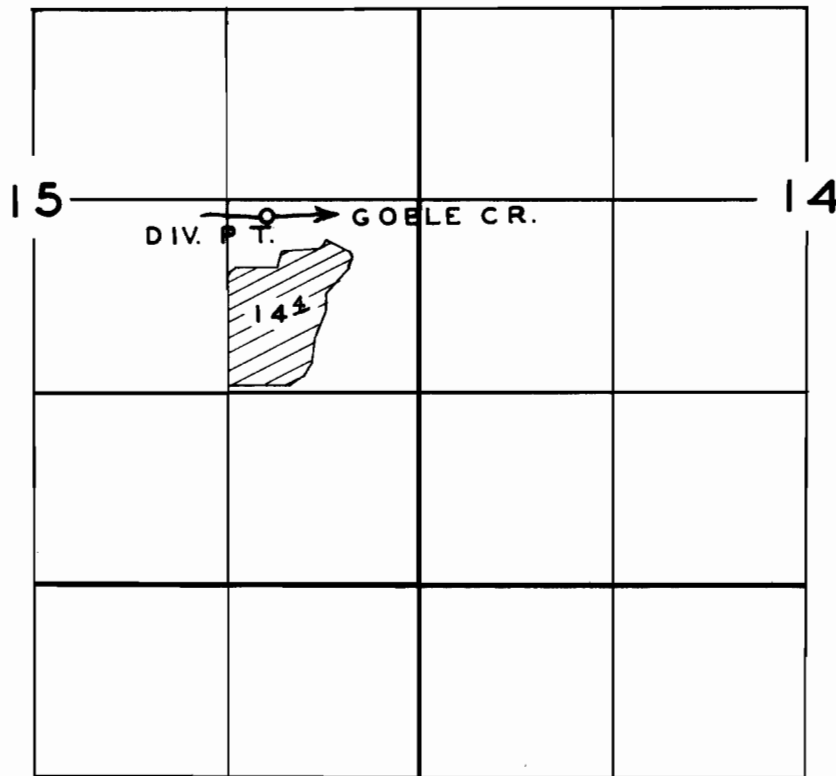

FINAL PROOF SURVEY

UNDER

Application No. 230.92 Permit No. 18211.....
IN NAME OF

CECIL C. URIE

Surveyed AUG. 23 1956, by R. H. WHITBY

1956 V
20 W 2.