


T. 7 S. R. 142 W. W.M.

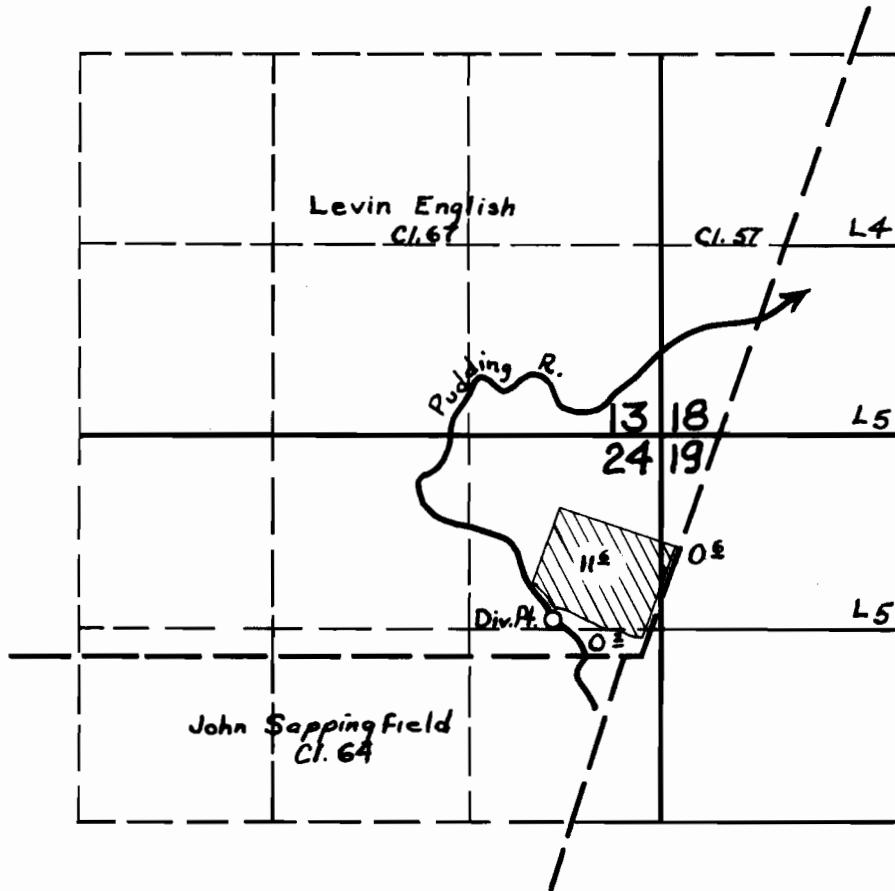

FINAL PROOF SURVEY
UNDER

Application No. 23144 Permit No. 18234
IN NAME OF

DAVID C. RAMSEYER JR.

Surveyed 28 Feb. 1956, by M. Bish