


T. 4 N. R. 2 W. W.M.

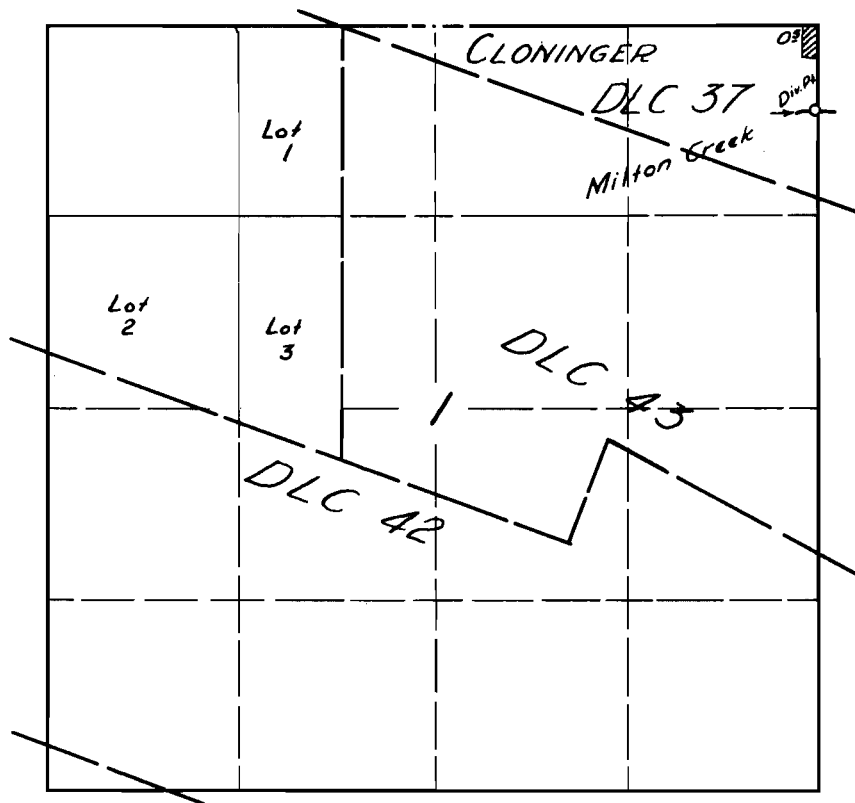

**FINAL PROOF SURVEY**

UNDER

Application No. 23248 Permit No. 18310

IN NAME OF

RUSSELL E. & MILDRED I. BOULBY

Surveyed 13 July 1956, by *R. Whitely*