


T. 9 S. R. 5 W. W. M.

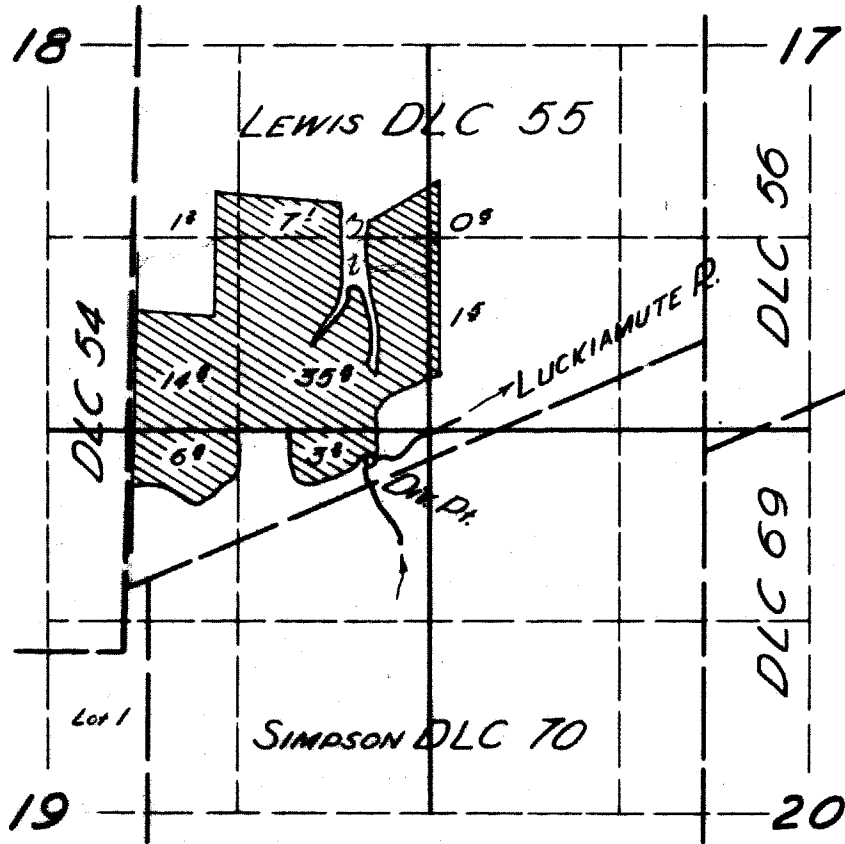

FINAL PROOF SURVEY

UNDER

Application No. 23181 Permit No. 18339

IN NAME OF

NORMAN S. RUNKLE

Surveyed 16 Aug. 1950, by [Signature]