


T. 9 S. R. 5 W. W. M.

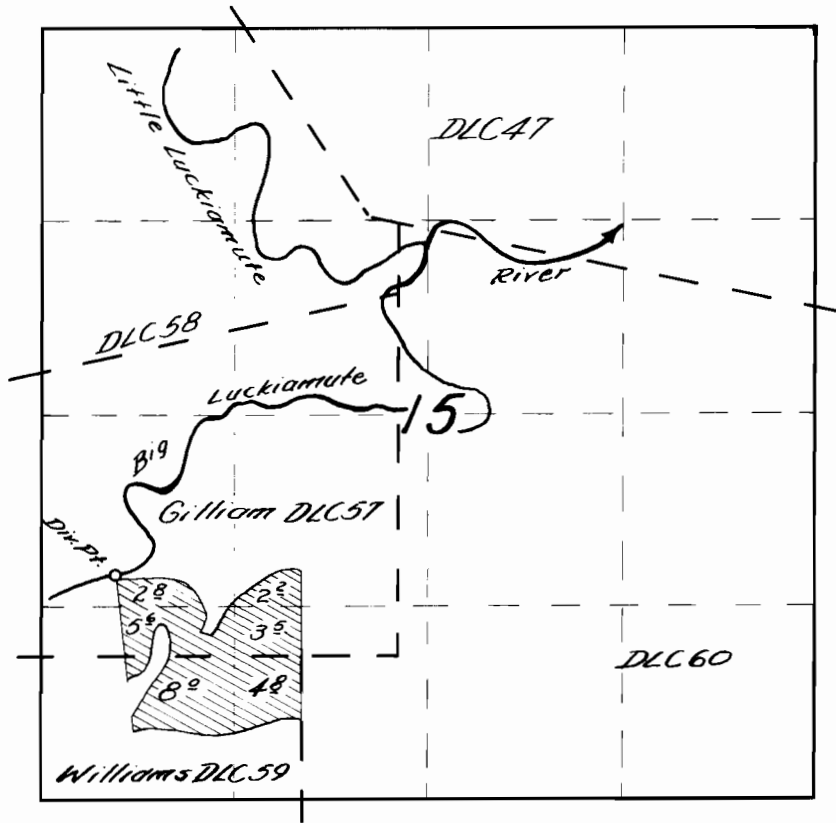

FINAL PROOF SURVEY

UNDER

Application No. 23540 Permit No. 18638

IN NAME OF

Mildred Hoover

Surveyed Aug. 15, 1956, by R. H. Whitby

DFP-2D-173