


T.9S. R.1W.W.M.

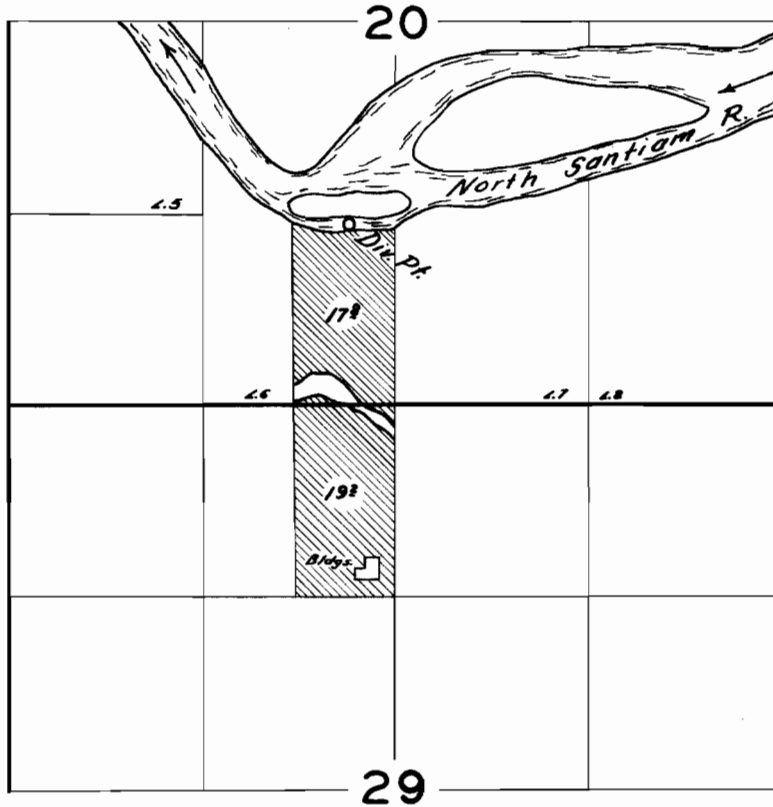

**FINAL PROOF SURVEY**

UNDER

Application No. 23825 Permit No. 18727

IN NAME OF

L. E. BRAMHALL

Surveyed July 26, 1956, by C. O. Bartels