


T. 4S. R. 2W. W.M.

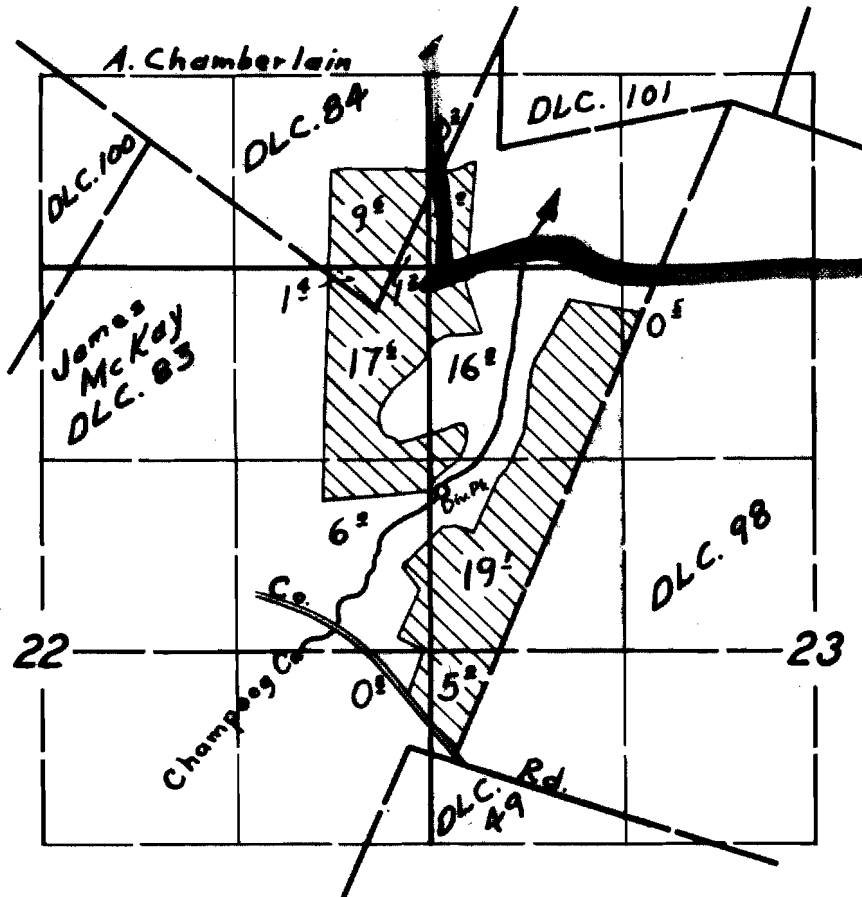

**FINAL PROOF SURVEY**

UNDER

Application No. 23594 Permit No. 18870

IN NAME OF

M. H. MERTEN

Surveyed 6 Sept. 1956, by M. Bish